

Morton


KANSAS

SECTION 34 TOWNSHIP 31 RANGE 42W

WELL NO. #1 Jackson Gas Unit

COMPANY Colorado Oil & Gas

NORTH

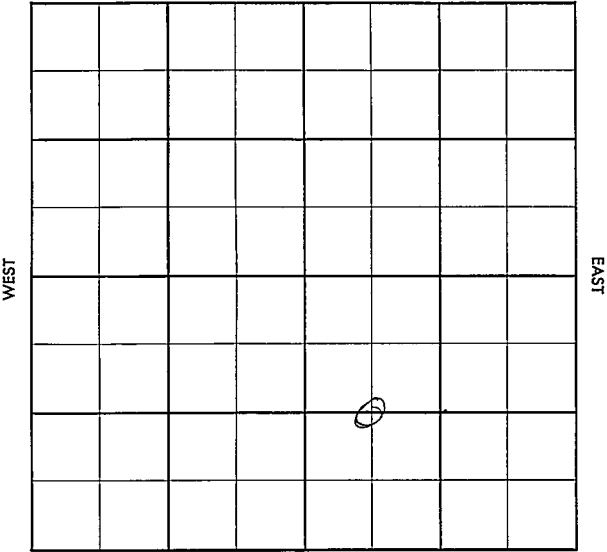

SOUTH

County Morton Elev. \_\_\_\_\_  
 Sec. 34 Twp. 31 Rge. 42W  
 Company Colorado Oil & Gas  
 Farm Name Jackson Gas Unit No. 1

TOPS	DEPTH	LOG	DATUM
Anh.			
Tp.			
H.			
Tr.			
Dg.			
Bl.			
L.			
K.C.			
B.K.C.			
Ce.			
C.			
M.			
M.			
K.			
Mz.			
Me.			
V.			
S.			
S.			
A.			
R.			
PE.			
G.			
T.D.			

Loc. in Sec. C W 1/2 SE  
 Geol. \_\_\_\_\_  
 Contr. Holme Drlg.  
 Pool Greenwood  
 FIRST REPORT  
 JAN 3 57

Date Comm. 12-29-56  
8" @ 707/500 drlg. 1847

34

Co.  
 Lse.  
 No.  
 Sec.  
 T.  
 R.

Edelita Kay


CORRECTION

FORM 513 SUNRAY

County Norton Elev. 3468  
 Sec. 2 Twp. 31 Rge. 42W  
 Company Superior & Carter  
 Farm Name Helmes Nickerson No. 1

TOPS	DEPTH	LOG	DATUM
Anh. <u>EM</u>		<u>3165</u>	
TP. <u>TP</u>		<u>3324</u>	
H. <u>20 CP</u>		<u>3476</u>	
Tr. <u>H6</u>		<u>3525</u>	
Dg. <u>TR</u>		<u>3607</u>	
Bl.			
L.		<u>3697</u>	
K.C.			
B.K.C. <u>Marm</u>		<u>4225</u>	
Ce. <u>MW Sh</u>		<u>4880</u>	
C. <u>" sd</u>		<u>5162</u>	
M.			
M. <u>MW For</u>		<u>5270</u>	
K. <u>Miss</u>		<u>5331</u>	
Mz.			
Mo.			
V.			
S.			
S.			
A.			
R.			
PE.			
G.			
TD.	<u>5327</u>		

Loc. in Sec. G SE/4  
 Miss Test  
 Geol.  
 Contr. COX  
 Pool Wildcat

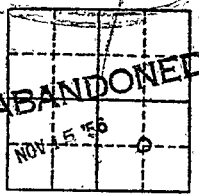

Date Comm. OCT 9 '56  
 MIRT, Location RUR OCT 10 '56 OCT 17 '56  
10-3-56 10<sup>3</sup>/<sub>4</sub> @ 1550/800  
Ø 3764 OCT 24 '56 Ø 4446 OCT 31 '56  
DIT 5166-5206 up 1hr rec.  
50' Md FP 15-15 BHP 40/30"  
DST 5195-5245 up 1hr rec  
30' Md FP 20-20 BHP 50/30"  
DST 5272-88 1hr NOV 7 '56 93' Md  
+ 657' SW FP 70-320 BHP

Co.  
 No.  
 Sec.  
 T.  
 R.

County Morton Elev. 3533  
 Sec. 34 Twp. 31 Rge. 42W  
 Company Colorado Oil & Gas  
 Farm Name Jackson Gas Unit No. 1

TOPS	DEPTH	LOG	DATUM	Loc in Sec.				
Ans				C W 1/2 SE				
Tp. <u>W 26</u>		<u>2798</u>						
H. <u>E 10</u>		<u>3044</u>						
Tr. <u>TP</u>		<u>3218</u>						
Dg.				Geol.				
Bl.				Contr.				
L.				<u>Holme Drlg.</u>				
K.C.				Pool				
R.K.C.				<u>Greenwood</u>				
Ce.				<table border="1"> <tr><td colspan="2">COMPLETE</td></tr> <tr><td colspan="2">JAN 30 57</td></tr> </table>	COMPLETE		JAN 30 57	
COMPLETE								
JAN 30 57								
C.								
M.								
M.								
K.								
Mz.								
Me.								
V.								
S.								
S.								
A.								
R.								
PE.								
G.								
T.D.	<u>3240</u>							

Date Comm. 12-29-56  
 8" @ 707/500 d rlg. 1847 JAN 9 57  
 5 1/2 3235 / 130 JAN 16 57 CO 3200  
 28 / 3180 - 87 16 / 3159 - 63 12 /  
 3149 - 52 28 / 3117 - 24 4 1/2 90  
 1,200 MCFG + 40 G. Acid wpl  
 PD 3090 12 / 3054 - 87 28 / 3044  
 - 51 8 / 3033 - 35 24 / 3015 - 21 12 /  
 2993 - 96 16 @ 40 G wpl + 556  
 to 59 JAN 20 57 16 90 100 MCFG

34-31-42

FORM 513-1 SUNRAY

+ 35 GWPH inc. to 500 MLFC  
CO 3235 PB 2955 12/2911  
-14 20/2891-96 36/2868-77  
8/2856-58 16 CO 3200  
9a 3,290 MLFC + 75 GWPH  
JAN 80 57 PB 2846 20/2831-36  
12/2827-30 12/2820-24  
20-/2812-17 20/2803-07  
9a 2,810 MLFC + 65 GWPH  
CO 2955 9a 2,810 MLFC  
+ 70 GWPH 72-20 9a  
6,400 MLFC 518 415

34-31-42W