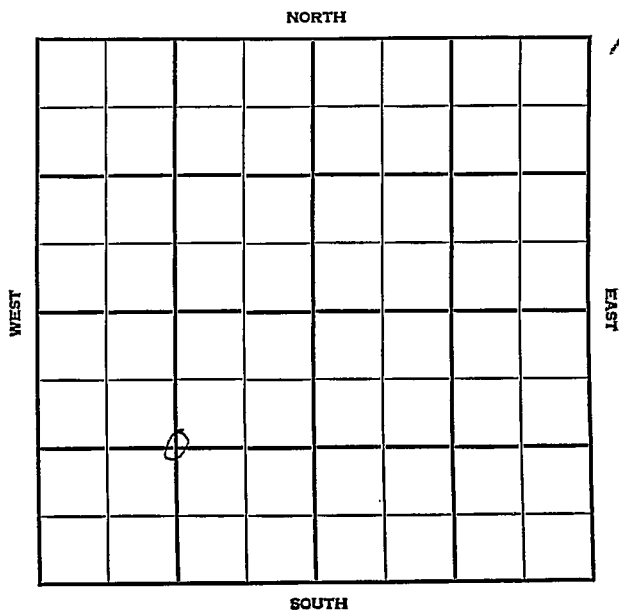


Section 14 Township 31 Range 43WWell No. 1 HenkeCompany Colo Oil & Gas

Morton

KANSAS

SEC.

14

TWP.

31S

R.

43W

WELL NO.

#1 Henke

FARM

COMPANY

Colo. Oil and Gas

CONTRACTOR

Peel Bros.


_____ Ft. from N. Line

_____ Ft. from S. Line

_____ Ft. from E. Line

_____ Ft. from W. Line

C SW/4

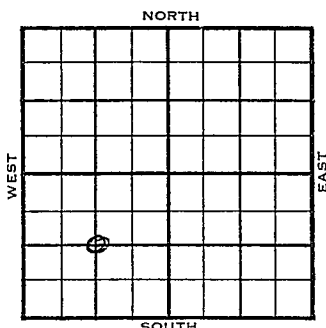

FIRST REPORT

1955

ELEVATION

3592'

REPORT

7/13

MIRT 7-11-55

8/31

Comm 7-11-55

Ip Waub

2775

2772

Elm

3048

TP

3198

Tr

3537

L

3603

KC Marm

3864

Ce

3960

Marsh

4798

4792

Keye

5063

Keye

5254

Mz

5263

TD

5332

DST 2780-2827 105" Rec 810' gas & swcm
BHP 360# 30"DST 3109-40 open 2 hrs, Rec 15' gcm
330# 30" Lost circ 3615DST 3775-3826 open 2 hrs Rec 725' gcm
pressures 0DST 3872-88 open 2 hrs Rec. 65' g &
swcm BHP 645 30"DST 5124-42 open 1 hr Rec 185' mud
plus 60' mcsw BHP 1080# 30"DST 5149-79 open 1 hr Rec 290' gcs
BHP 1160 30" D & A

ABANDONED

County Morton

Elev. _____


TOPS

DEPTH

LOG

DATUM

Loc. in Sec. _____

Anh. _____

Tp. _____

H. _____

Tr. _____

Dg. _____

Bl. _____

L. _____

K.C. _____

B.K.C. _____

Ce. _____

C. _____

M. _____

M. _____

K. _____

Mz. _____

Ma. _____

V. _____

S. _____

S. _____

A. _____

R. _____

PE. _____

G. _____

T.D. _____

Geol. _____

Contr. _____

Pool Bros. _____

Pool _____

Greenwood

FIRST REPORT

JUL 13 '55

Date Comm. MIET 7-11-55~~37~~

County Morton Elev. 3592
 Sec. 14 Twp. 31S Rge. 43W
 Company Colo. Oil and Gas
 Farm Name Henke No. 1

TOPS	DEPTH	LOG	DATUM	Loc. in Sec.
Anb.				C SW/4
Ip. Waub	2775	2772		
H.				
Fr. E/m		3048		
Dg. TP		3198		Geol.
Bb. Tr		3537		
L.		3603	11	
K.C. Manm		3864	272	
B.K.G.				Contr.
Ce.	3960			
G. Marsh	4798	4792	1200	
M. Keye	5063		1471	
MB		5254	1662	Pool
K. Miss		5263	1671	
Mz.				
Ma.				
V.				Greenwood
S.				
S.				
A.				
R.				
PE.				
G.				
T.D.	5332			

ABANDONED

Date Comm. 7/11/55 AUG 31 1955

DST 2780-2827 105" Rec. 810' gas & swcm

BHP 360# 30" DST 3109-40 open 2 hrs.

Rec. 15' gcm 330# 30" Lost Circ 3615

DST 3775-3826 open 2 hrs. Rec. 725' gcm
 pressures 0 DST 3872-88 open 2 hrs Rec.

65' g & swcm BHP 645 30" DST 5124-42

open 1 hr. Rec. 185' mud plus 60' mcs w

BHP 1080# 30" DST 5149-79 open 1 hr Rec.

290' gcs w BHP 1160 30" D & A