

Morton KANSAS

Well No. # 1 Hanna Unit

Company Superior Oil

WEST

EAST

SOUTH

Morton

KANSAS

SEC.	TWP.	R.
32	31	43W
WELL NO. #1 Hanna Unit		
FARM		
COMPANY Superior Oil		
CONTRACTOR		


Dreyer Pool

_____ Ft. from N. Line

330 _____ Ft. from S. Line

330 _____ Ft. from E. Line

_____ Ft. from W. Line

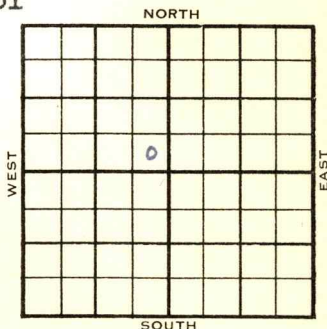

SE SE NW

1954

ELEVATION

3642'

REPORT

11/17

Spud 10-25-54

10" @ 629'

TD 3455'

1955

1/5

Spud 10-25-54 Gas well TD 3455

10" @ 629 Neva 2558 Wab. 2884

Elmont 2992 Top. 3168 LeCompton 3302

TD 3455 CO to 3386 4/3086-87

B/4 GMW 42/3174-81 60/3188-98

1000 A S/10 BW 4 hr. 1,385,000 CFG

3000 A 985,000 CFG SP 3155

66/3090-3100 54/3116-25

36/3135-41 2000 A 5,165,000 CFG

CO to 3386 F/5,165,000

Comp. open flow 3,235,000 CFG 403#

COMPLETED

County **Morton** State **Kansas**

Sec. **32** (Blk. Twp.) **31** (Sur. Rge.) **43W** Map No.

Operator Superior Oil

Well No. **1** Farm **Hanna Unit**

Elev.	3642	Location	SE SE NW
-------	------	----------	----------

0

FIRST REPORT

330 Ft. From S Line NW

330 Ft. From E Line Quarter

1st. Report NOV 17 1954

Completion

Remarks

Spudding Date 10-25-54

Drlg. Data Dreyer Pool

10" @ 629 TD 3455

FABEN GILSTRAP

County Morton State KansasSec. 32 (Blk. Twp.) 31 (Sur. Rge.) 4 3W Map No.Operator Superior OilWell No. 1 Farm Hanna UnitElev. 3642 Location SE SE NW330 Ft. From S Line NW330 Ft. From E Line Quarter

1st. Report

Completion JAN 5 1955Remarks Dreyer PoolSpudding Date 10-25-54Drlg. Data Gas well TD 345510" @ 629 Neva 2558 Wab. 2884Elmont 2992 Top. 3168 LeCompton 3302TD 3455 CO to 3386 4/ 3086-87B/ 4 gmw 42/ 3174-81 60/ 3188-981000 A S/ 10 bw 4 hr. 1,385,000 cfg3000 A 985,000 cfg SP 3155 66/ 3090-3100 54/ 3116-25 36/ 3135-41 2000 A5,165,000 cfg CO to 3386 F/ 5,165,000Comp. open flow 3,235,000 cfg 403#

FABEN GILSTRAP