

DX 78-1


Morton

KANSAS

Section 34 Township 31 Range 43 W

Well No. # 1 Breyer

Company Colorado Oil & Gas

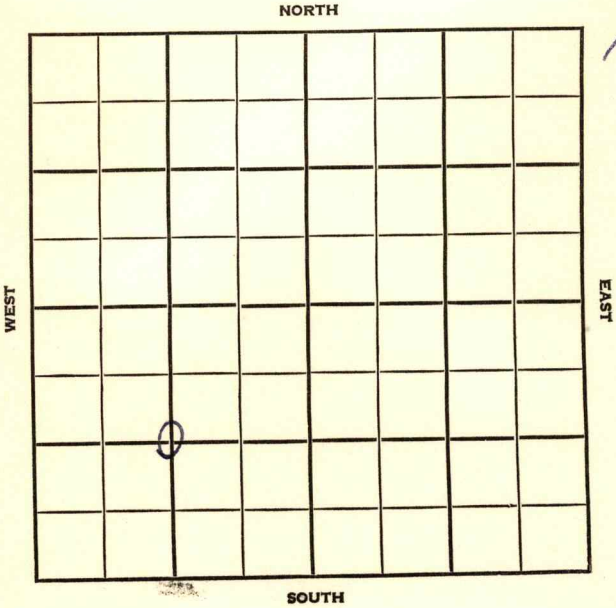

Morton

KANSAS

SEC.	TWP.	R.
34	31	43 W

WELL NO. # 1 Dreyer FARM

COMPANY

Colorado Oil & Gas

CONTRACTOR

Holm

Dreyer Pool


Ft. from N. Line

1320 Ft. from S. Line

Ft. from E. Line

1320 Ft. from W. Line

C SW/4

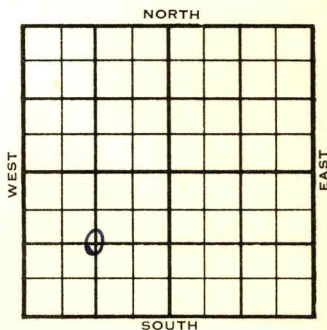

ELEVATION

REPORT

1955

3595'

1/12

MIR

2/23

Spud 1-6-55 D & A TD 3337
 8" @ 631 Wab. 2774'
 DST 2774-2840 open 2 hr rec 15' mud 385#.
 DST 2877-2945 open 2 hr rec 30' mud. 415#.
 DST 2950-3005 rec 15' mud 410#
 TD 3337' 5" @ 3334 CO to 3303
 28/3278-85 1000 A 20 GWPH
 CO to 3265 16/3259-63 1000 A
 200 GWPH CO to 3226 24/3201-07
 CO to 3198 16/3190-94 1000 A
 24/3176-82 1000 A 16/3132-36
 1000 A 24/3113-19 1500 A wtr.
 LOG TOPS: Wab 2773 Elmont 3017
 Top 3176 LeCompton 3312'
 TD 3337' D & A

ABANDONED

County Morton State Kansas
 Sec. 34 (Blk. 31 (Sur. 43W Map No. 31)
 Operator Colorado Oil & Gas
 Well No. 1 Farm Dreyer
 Elev. 3595 Location C SW/4



1320 Ft. From S Line SW
1320 Ft. From W Line Quarter
 1st. Report
 Completion FEB 23 1955
 Remarks Dreyer Pool
Holm - Contr.
 Spudding Date 1-6-55

Drlg. Data D & A TD 3337
8" @ 631 Wab. 2774 DST 2774-2840
open 2 hr. Rec. 15' mud 385#
DST 2877-2945 open 2 hr. Rec. 30' mud
415# DST 2950-3005 Rec. 15' mud 410#
TD 3337 5" @ 3334 CO to 3303 28/ 3278-
85 1000 A 20 gwph CO to 3265
16/ 3259-63 1000 A 200 gwph
CO to 3226 24/ 3201-07 CO to 3198
16/ 3190-94 1000 A 24/ 3176-82
1000 A 16/ 3132-36 1000 A 24/ 3113-19
1500 A wtr. LOG TOPS:
Wab. 2773 Elmont 3017 Top. 3176
LeCompton 3312 TD 3337

D & A

FABEN GILSTRAP

County **Morton** State **Kansas**
 Sec. **34** (Blk. **31** (Sur. **43W** Map No.
 (Twp.) (Rge.)
 Operator **Colorado Oil & Gas**
 Well No. **1** Farm **Dreyer**
 Elev. **3595** Location **C SW/4**



1320 Ft. From **S** Line **SW**
1320 Ft. From **W** Line Quarter

1st. Report **JAN 1 2 1955**

Completion

Remarks

Holm - Contr.

Spudding Date

Drlg. Data

Dreyer Pool

M I R

FABEN GILSTR