

Morton

KANSAS

SECTION 27 TOWNSHIP 31 RANGE 43 W

WELL NO. #1 Bogart


COMPANY Superior Oil

NORTH

9

WEST

EAST

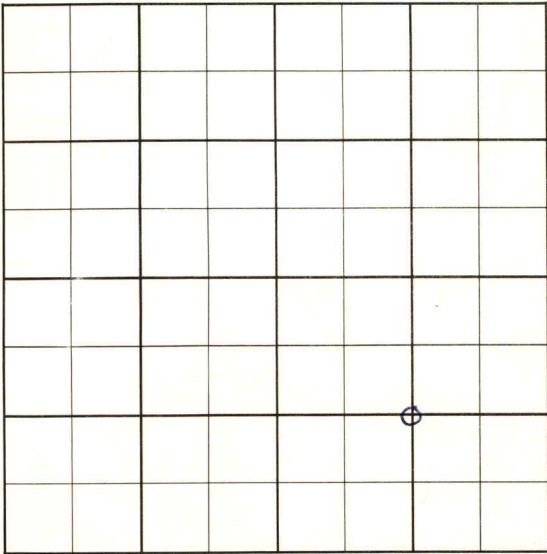

SOUTH

Morton

KANSAS

SEC.	TWP.	R.
27	31	43W

WELL NO.

#1 Bogart

FARM

COMPANY

Superior Oil

CONTRACTOR

Greenwood


Ft. from N. Line

Ft. from S. Line

Ft. from E. Line

Ft. from W. Line

C SE/4

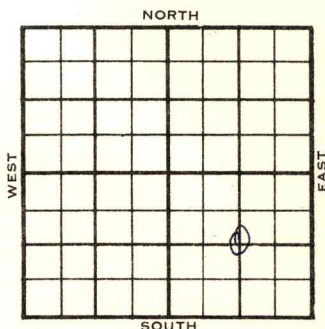

1955

ELEVATION

3576

REPORT

12-28

Comm. 12-20-55

10" @ 676/400

Drl g. 2588

1956

2-1

7" @ 3338/400

CO to 3287 4/ 3168-69, 20/ 3168-73

1000 A, SP 3150

64/ 3106-14, 32/ 3124-28, 1500 A,

SP 3065

Sq 3106-14, 3124-28

CO to 3065, 4/3016-17, 32/3016-20,

1000 A

S/ 30 bw 4 $\frac{1}{2}$ hrs.~~4/ 2964-65, 56/2964-71, 32/ 2982-86, 16/2998-3000, dry, 1000 A~~~~4/ 2964-65, 56/2964-71, 32/ 2982-86, 16/2998-3000, dry, 1000 A~~S/ 26 bw 1 $\frac{1}{2}$ hr.,

32/ 2828-32, dry 1000 A, 4 bw 6 hrs.

32/ 2784-88, 1000 A, 5 bw 5 hrs.,

D & A

Log topd: Waub 2756

Elmont 3015

Top 3166

LeComp. 3308

TD 3334'

ABANDONED

County Morton

Elev. _____

Sec. 27Twp. 31Rge. 43WCompany Superior OilFarm Name BogartNo. 1

TOPS

DEPTH

LOG

DATUM

Loc. in Sec. _____

Anh.

Tp.

H.

Tr.

Dg.

B.L.

L.

K.C.

B.K.C.

Ce.

C.

M.

M.

K.

Mz.

Mq.

V.

S.

S.

A.

R.

Pc.

G.

T.D.

C SE/4

Topeka test

Geol. _____

Contr. _____

Pool

Greenwood

DEC 28 55

FIRST REPORT

Date Comm. 12-20-55

10" @ 676/400 d rlg. 2588

34

County Morton Elev. 3576
 Sec. 27 Twp. 31 Rge. 43W
 Company Superior Oil
 Farm Name Bogart No. 1

TOPS	DEPTH	LOG	DATUM	Loc. in Sec.
Anh.				C SE/4
Tp. <u>Waub</u>		<u>2756</u>		
H. <u>Elmont</u>		<u>3015</u>		
Tr. <u>Top</u>		<u>3166</u>		
Dg. <u>2 Comp</u>		<u>3308</u>		
Bl.				
L.				
K.C.				Geol.
B.K.C.				Contr.
Ce.				
C.				
M.				
M.				Pool
K.				Greenwood
Mz.				
Mq.				
V.				
S.				
S.				
A.				
R.				
Pf.				
G.				
T.D.	<u>3334</u>			

ABANDONED

Date Comm. 12-20-55 FEB 1 1956

10" @ 676/400 7" @ 3338/400

C0 to 3287 4/ 3168-69 20/3168-73

1000 A SP 3150 64/ 3106-14

32/ 3124-28 1500 A SP 3065

Sq 3106-14 3124-28 C0 to 3065

4/ 3016-17 32/ 3016-20 1000 A

S/ 30 bw 4 $\frac{1}{2}$ hr. 4/ 2964-65

56/ 2964-71 32/ 2982-86 16/ 2998-3000

dry 1000 A S/ 26 bw $1\frac{1}{2}$ hr.

32/ 2828-32 dry 1000 A $\frac{1}{4}$ bw 6 hr.

32/ 2784-88 1000 A 5 bw 5 hr.

D & A

R. G.

FEB 9 1956