

Morton

KANSAS

SECTION 28 TOWNSHIP 31S RANGE 43W

WELL NO. #1 Uhl

COMPANY ~~#####~~ Omego Oil - Skelly 1/4 Int.


NORTH

C SW/4

//

WEST

EAST

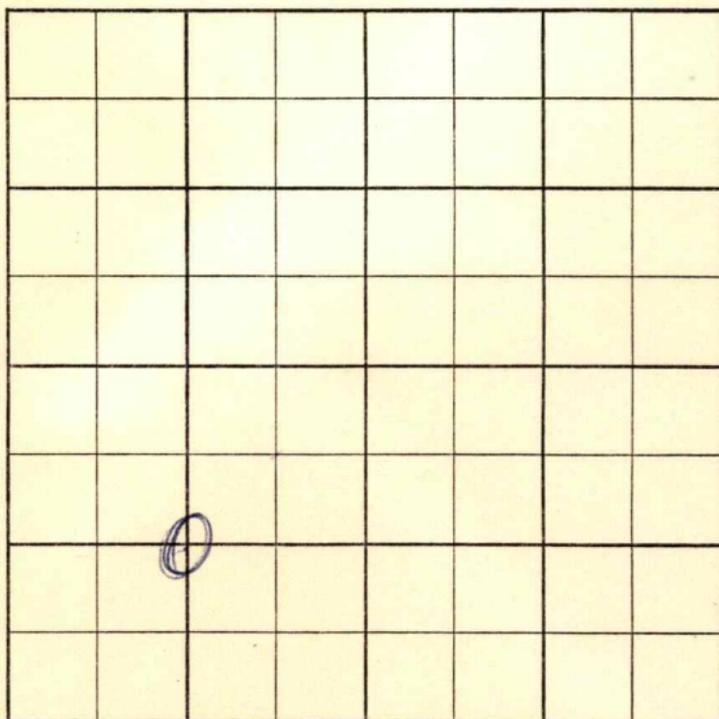

SOUTH



