


Section 5 Township 31 Range 12W

Well No. #1 Bush CARRY

Company Alpine Oil

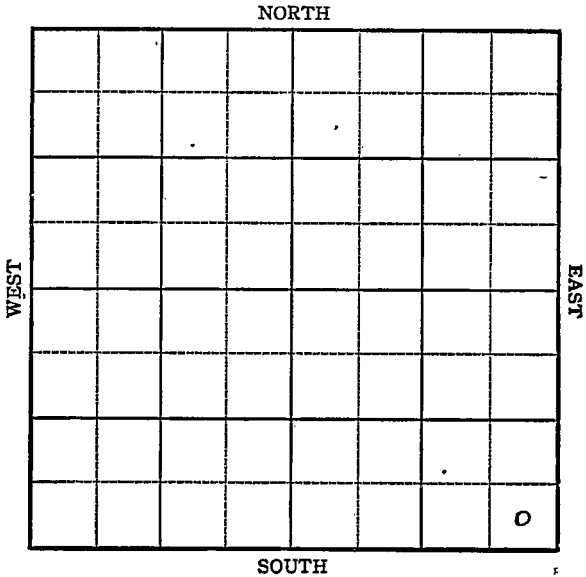


KANSAS

Barber

Sec. 5 Twp. 31 R. 12WWell No. #1 Bush CURRY FarmAlpine Oil Company

Wildcat

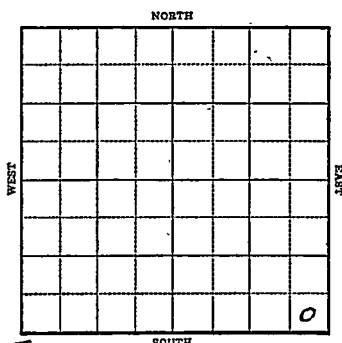 Ft. from N. Line330 Ft. from S. Line330 Ft. from E. Line Ft. from W. LineSE/C Elev. 1825

SOUTH

1944

R E P O R T

2/9 Location

2/15 "

2/23 Derrick

3/1 Rotary

3/8 "

3/16 10" @ 195
Drilling 10503/22 Any 690
Drlg. 23403/29 Topeka 3392
Lans 3903
Drlg. 42504/5 Miss 4436
Kind 4480
Viola 4592
Drlg. 4639

OVER

1944

4/12

Arb 4804

T^D 4834

~~ABANDONED~~

KANCA
Map No. 61 Sec. 5 Twp. 31 R. 12W

Well No. 1 Bush

Alpine Oil Company

FIRST REPORT Contractor

SE/C


SECTION PLAT

 Ft. from N. Line

330 Ft. from S. Line

330 Ft. from E. Line

 Ft. from W. Line

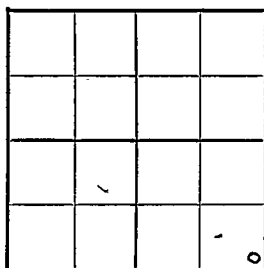

Wildcat

Location X

Rig up

Drilling and Remarks:

RECORD

Cased in., ft.

Sand

Gas

Oil

Total Depth

PRODUCTION

1st 24 hrs. Nat.

1st 24 hrs. after shot

Gas Cu. Ft.

Dry Hole

Abandoned

Date

FEB 9 1944 19

S. J. LEWIS Scout


Misc. Small Maps *Osma*
Cards *Madge*
Tracing *Wood*
Trance Map *-*
Carberough Map */*
Aody Map *-*
Geological Dept. */*
Aody Plat Book */*

KANSAS

Map No. 61. Sec. 5 Twp. 31 R. 12WWell No. 1 CurryAlpine Oil CompanyCORRECTION Contractor

SE/C

SECTION PLAT

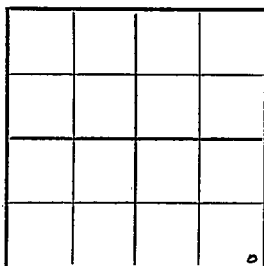 Ft. from N. Line330 Ft. from S. Line330 Ft. from E. Line Ft. from W. Line

Wild cat

Location Rig up

Drilling and Remarks:

Reported
#1 Bush

RECORD


Cased in., ft.Sand Gas Oil Total Depth

PRODUCTION

1st 24 hrs. Nat. 1st 24 hrs. after shot Gas Cu. Ft.Dry Hole Abandoned

Date

FEB 16 1944 19 S. J. LEWIS Scout

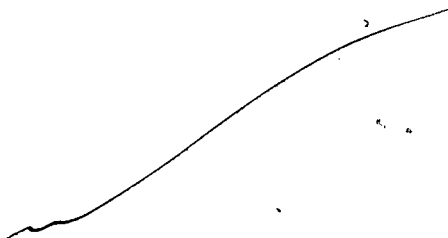

Misc. Small Maps

Cards

Tracing

France Map

Scarborough Map

Moody Map

Geological Dept.

Moody Plat Book

KANSAS

Map No. 61 Sec. 5 Twp. 31 R. 12WWell No. 1 CureyAlpine Oil


Company

ABANDONED

Contractor

SE /C

SECTION PLAT

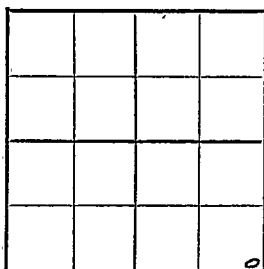 Ft. from N. Line330 Ft. from S. Line330 Ft. from E. Line Ft. from W. LineWildcatLocation Rig up

Drilling and Remarks:

Per 4804

RECORD

Cased in., ft.Sand Gas Oil Total Depth 4834

PRODUCTION

1st 24 hrs. Nat. 1st 24 hrs. after shot Gas Cu. Ft.Dry Hole Abandoned

Date

APR 12 1944 19

S. J. LEWIS

Scout

Misc. *Madge*
 Carc. *Madge*
 Tracing *Madge*
 Trance Map *Madge*
 Harborborough I. *Madge*
 ody Map *Madge*
 'ological Dept. *Madge*
 ndy Plat Book *Madge*