


Barber county

Section 5 Township 31 Range 14-W

Well No. #1, T. H. Mills

Company Amerada Petroleum Company

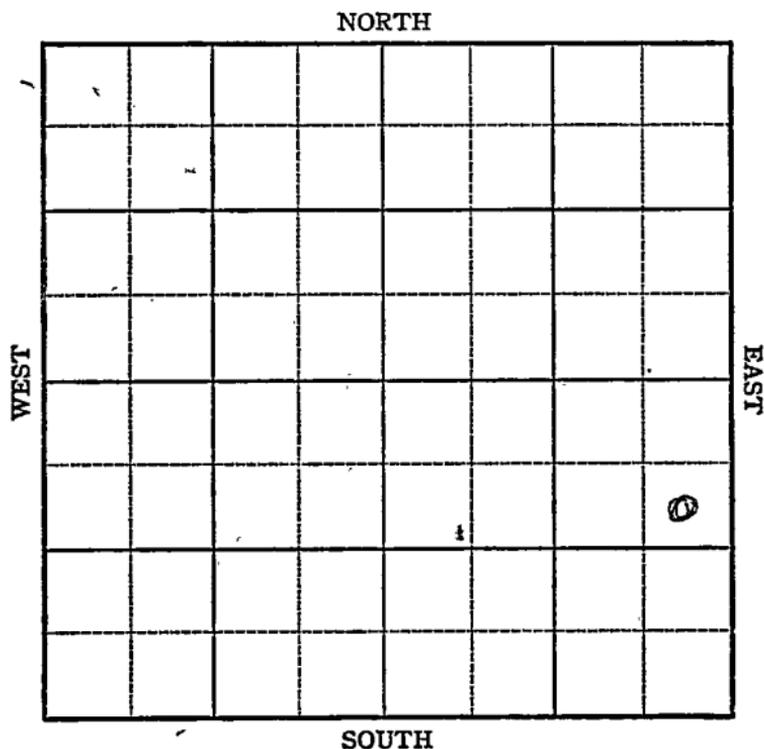

Sec. 5 Twp. 31 R. 14-W

Well No. #1, T. H. Mills Farm \_\_\_\_\_

Amerada Company

Skinner Pool


990' Ft. from N. Line

\_\_\_\_\_ Ft. from S. Line

330' Ft. from E. Line

\_\_\_\_\_ Ft. from W. Line

SE NE SE

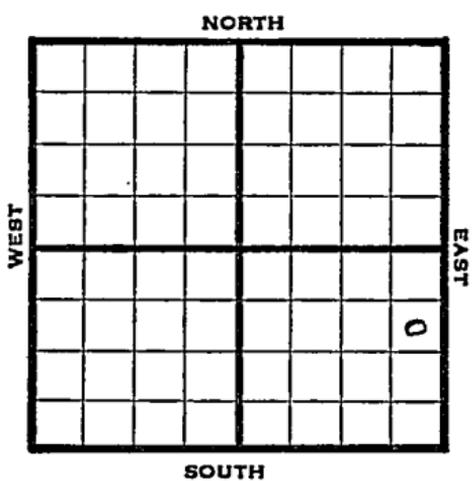

1946 Elev. 1686 REPORT

12/4	Location
12/10	Drlg 300'
12/17	8" @ 877' Drlg 2192'
1947	
1/4	Douglas 3681' Lans 3798' Drlg 4317'
1/8	Magu 4398' Viola 4432' Simp 4520' Simp sd 4520' TD 4529'
1/15	Simp. Sd 4520' TD 4531'

**ABANDONED**

Kansas

Map No. 93 Sec. 5 Twp. 31 R. 14WWell No. 1 T. H. MillsAmerada Company

FIRST REPORT Contractor

SE NE SE


## SECTION PLAT

990 Ft. from N. Line

\_\_\_\_\_ Ft. from S. Line

330 Ft. from E. Line

\_\_\_\_\_ Ft. from W. Line

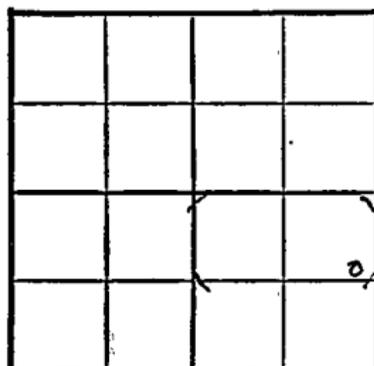

Barber County

Location X

Rig up \_\_\_\_\_

Drilling and Remarks:

## RECORD

Cased \_\_\_\_\_ in. \_\_\_\_\_ ft.

Sand \_\_\_\_\_

Gas \_\_\_\_\_

Oil \_\_\_\_\_

Total Depth \_\_\_\_\_

## PRODUCTION

1st 24 hrs. Nat. \_\_\_\_\_

1st 24 hrs. after shot \_\_\_\_\_

Gas \_\_\_\_\_ Cu. Ft.

Dry Hole \_\_\_\_\_

Abandoned \_\_\_\_\_

Date

DEC 4 1946 19S. J. LEWIS Scout

Kansas **KANSAS**

Skinner Pool

Map No. 93 Sec. 5 Twp. 31 R. 14W

Well No. 1 T. H. Mills

Amerada Company

**ABANDONED**

Contractor

SE NE SE

*E/1/686*

SECTION PLAT

990 Ft. from N. Line

\_\_\_\_\_ Ft. from S. Line

330 Ft. from E. Line

\_\_\_\_\_ Ft. from W. Line


Barber County

Location \_\_\_\_\_

Rig up \_\_\_\_\_

Drilling and Remarks:

*Emp Sol 4520*

**RECORD**

Cased \_\_\_\_\_ in., \_\_\_\_\_ ft.

Sand \_\_\_\_\_

Gas \_\_\_\_\_

Oil \_\_\_\_\_

Total Depth 4531

**PRODUCTION**

1st 24 hrs. Nat. \_\_\_\_\_

1st 24 hrs. after shot: \_\_\_\_\_

Gas \_\_\_\_\_ Cu. Ft.

Dry Hole \_\_\_\_\_

Abandoned \_\_\_\_\_

Date

JAN 15 1947 19

S. J. LEWIS

Scout