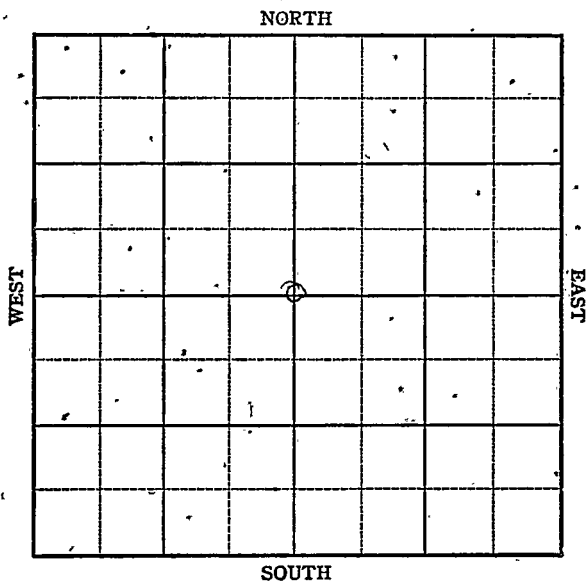


KANSAS

Stevens

Section 5 Township 31 Range 38-WWell No. #1 WittCompany Stanolind

KANSAS Hugoton Pool

Sec. 5 Twp. 31 R. 38-W ✓

Well No. 1 Witt Farm

Stanolind Company


C Sec.

2640 Ft. from N. Line

 Ft. from S. Line

2640 Ft. from E. Line

 Ft. from W. Line

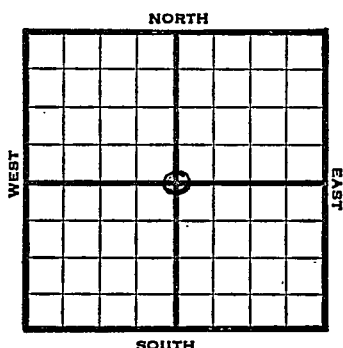

Stevens County

1947

Elev. 3161

REPORT

2-12 8" @ 604 WoC

2/19 TD 2700'
5" @ 2609
RUST

2/26 5" @ 2609'
Perf
16,000 Acid
14,496,000 Gas
380# R Pr
TD 2700'

COMPLETED

Map No. _____ Sec. 5 ~~KANSAS~~ 31 R. 38W
Twp. 4S

Well No. 1 Witt


Stanolind Company

FIRST REPORT

Contractor

C Sec.

SECTION PLAT

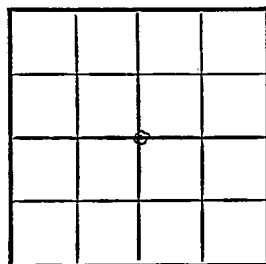

2640 Ft. from N. Line

_____ Ft. from S. Line

2640 Ft. from E. Line

_____ Ft. from W. Line

Stevens County

Location _____

Rig up _____

Drilling and Remarks:

8" @ 604 WOC

RECORD

Cased _____ in., _____ ft.

Sand _____

Gas _____

Oil _____

Total Depth _____

PRODUCTION

1st 24 hrs. Nat. _____

1st 24 hrs. after shot _____

Gas _____ Cu. Ft.

Dry Hole _____

Abandoned _____

Date

FEB 1 2 1947

19

S. J. LEWIS

Scout

Map No. _____ Sec. 5 Twp. 31 R. 38W

Well No. 1 Witt

Stanolind Company

COMPLETE

Contractor

C Sec.


E13161
SECTION PLAT

2640 Ft. from N. Line

_____ Ft. from S. Line

2640 Ft. from E. Line

_____ Ft. from W. Line

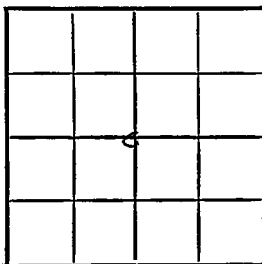

Stevens County

Location _____

Rig up _____

Drilling and Remarks: _____

5" @ 2609'
Perf.
16,000 cu. ft.

14,496,000 Gas

*880 * R/A*

RECORD

Cased _____ in., _____ ft.

Sand _____

Gas _____

Oil _____

Total Depth 2700

PRODUCTION

1st 24 hrs. Nat. _____

1st 24 hrs. after shot _____

Gas _____ Cu. Ft.

Dry Hole _____

Abandoned _____

Date

FEB 26 1947 19

S. J. LEWIS Scout