


Section..... 5 .....Township..... 31 .....Range 34-W

Well Number..... 1 Young

Company..... United Production

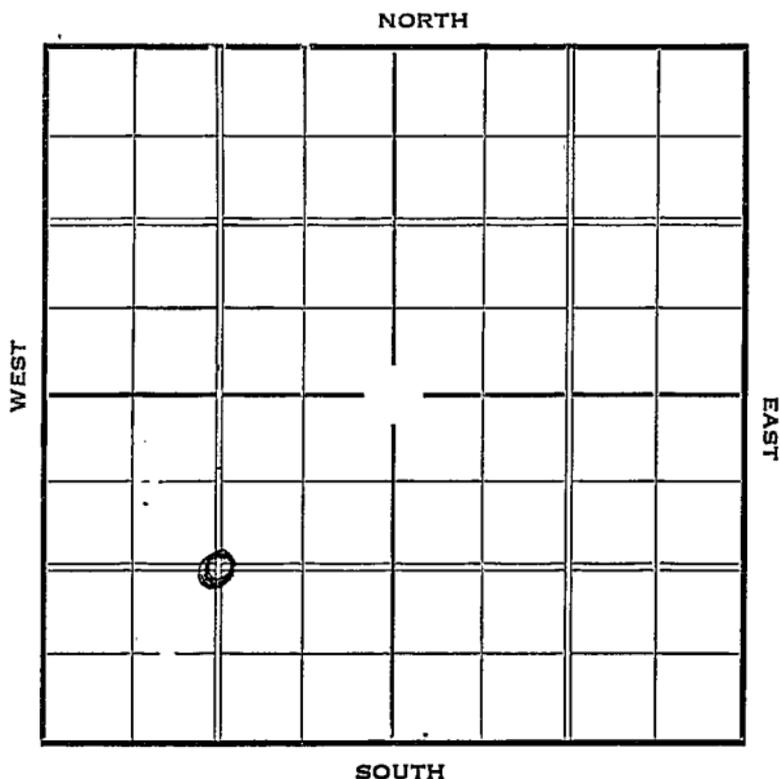



1937

6/23

7<sup>h</sup> @ 2404'.

Sand 2620'.

T.D. 2875'.

P.B. 2647'.

Shot 60 qts.

2 M gas.

**COMPLETED**

Map No. *N. M.* Sec. *5* Twp. *31* R. *34W*Well No. *1 Young**United Production* Company

Contractor

**Special****SECTION PLAT**

\_\_\_\_\_ Ft. from N. Line

*1820* Ft. from S. Line

\_\_\_\_\_ Ft. from E. Line

*1820* Ft. from W. Line


**FIRST REPORT**Location *✓*

Rig up \_\_\_\_\_

Drilling and Remarks:

**RECORD**

Cased \_\_\_\_\_ in., \_\_\_\_\_ ft.

Sand \_\_\_\_\_

Gas \_\_\_\_\_

Oil \_\_\_\_\_

Total Depth \_\_\_\_\_

**PRODUCTION**

1st 24 hrs. Nat. \_\_\_\_\_

1st 24 hrs. after shot \_\_\_\_\_

Gas \_\_\_\_\_ Cu. Ft.

Dry Hole \_\_\_\_\_

Abandoned \_\_\_\_\_

Date

MAR 2 1937

Returned \_\_\_\_\_

Cards \_\_\_\_\_ *Paul*

Tracing \_\_\_\_\_

France Map \_\_\_\_\_ *✓*

Scarborough Map \_\_\_\_\_ *X*

Moody Map \_\_\_\_\_ *X*

Scarborough Plat Book \_\_\_\_\_

Moody Plat Book \_\_\_\_\_

*no  
no*

*Paul*

*Paul*

Seward KANSAS

Map No. 1257125 Sec. 5 Twp. 31 R. 34 WWell No. 1 - YoungUnited Prod. Company

Contractor

## SECTION PLAT

COMPLETED


\_\_\_\_\_ Ft. from N. Line

1320 Ft. from S. Line

\_\_\_\_\_ Ft. from E. Line

1320 Ft. from W. Line

## RECORD

Location \_\_\_\_\_

Rig up \_\_\_\_\_

Drilling and Remarks:

P.B. 2647SHOT - 60-gts2 M gasCased 7 in., 2404 ft.Sand 2620

Gas \_\_\_\_\_

Oil \_\_\_\_\_

Total Depth 2875

## PRODUCTION

1st 24 hrs. Nat. \_\_\_\_\_

1st 24 hrs. after shot \_\_\_\_\_

Gas \_\_\_\_\_ Cu. Ft.

Dry Hole \_\_\_\_\_

Abandoned: \_\_\_\_\_

Date

JUN 23 1937 19

H. D. Hatfield

Scout

*Handwritten scribbles and lines*

*Roddy*

Returned	_____
Cards	_____ <i>Paul</i>
Tracing	_____ <i>X</i>
France Map	_____ <i>X</i>
Scarborough Map	_____ <i>X</i>
Moody Map	_____ <i>X</i>
Scarborough Plat Book	_____
Moody Plat Book	_____