


DX 78-1

Section 5 Township 31S Range 15W

Well No. #1 Moad

Company Jones, Shelburne & Farmer

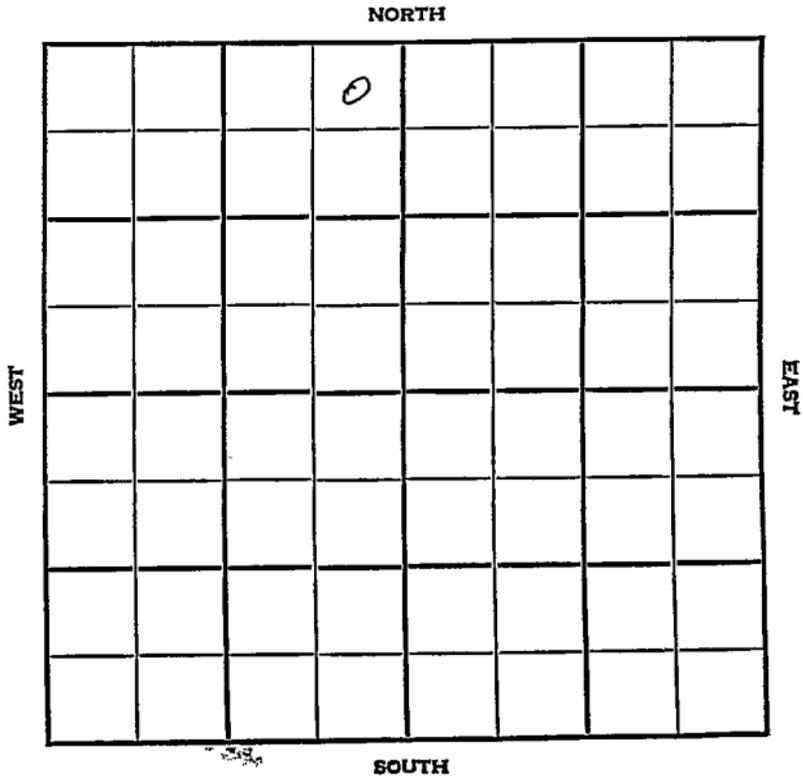

SEC. 5	TWP. 31S	R. 15W
-----------	-------------	-----------

WELL NO.

1 Moad

FARM

COMPANY


Jones, Shelburne & Farmer  
CONTRACTORCo. rig #5  
(WILDCAT)

\_\_\_\_\_ FT. FROM N. LINE

\_\_\_\_\_ FT. FROM S. LINE

\_\_\_\_\_ FT. FROM E. LINE

\_\_\_\_\_ FT. FROM W. LINE

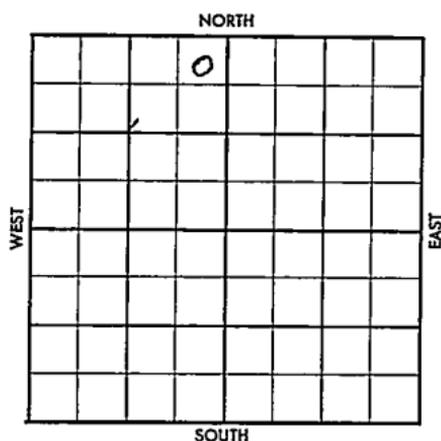NE-NE NW  
(N/2 NW/4)

CSO - FO

	ELEVATION	REPORT
1956	1884 RB	
6-20	Comm. 6-17-56 8" @ 835 w/350 Drlg. 900	
7-18	DST 3881-91 op 30 min. rec. 10' mud, 90/20" DST 4435-4510 op 1 hr, rec. 30' mdy oil / 120' OGM, 460/20" DST 4636-60 op 1 hr, rec. 30' mud, BHP 0#. DST 4663-4700 op 1 hr. rec. 3300' SW, BHP 1700/20" DST 4798-4805 op 1 hr. rec. 5' mud, BHP 0/20" D & A H. 3832'; Dg. 3879'; L. 4025'; L. 4025'; Massey 4470'; M. 4564'; Mz. 4634'; V. 4638'; S. 4797'; A. 4885' Log tops: H. 3829'; Dg. 3892'; BL. 4008'; L. 4031' Massey 4470'; M. 4580'; Mz. 4641'; V. 4645'; S. 4810'; A. 4898'; TD 4933'	

ABANDONED

County Barber

Elev. \_\_\_\_\_

Sec. 5

Twp. 31S

Rge. 15W

Company Jones, Shelburne & Farmer

Farm Name Moad

No. 1

TOPS	DEPTH	LOG	DATUM
Anh.			
TP.			
H.			
Tr.			
Dg.			
Bl.			
L.			
K.C.			
B.K.C.			
Ce.			
C.			
M.			
M.			
K.			
Mz.			
Me.			
V.			
S.			
S.			
A.			
R.			
PE.			
G.			
TD.			

Loc. in Sec. \_\_\_\_\_

NE NE NW

CSO - FO

(N $\frac{1}{2}$ NW $\frac{1}{2}$ )

Geol. \_\_\_\_\_

Contr. Co.

rig #5

Pool \_\_\_\_\_

W.C.

		o	

**FIRST REPORT**

Date Comm. 6-17-56

JUN 20 '56

8 $\frac{1}{2}$  835 w/350; D 900

*TH S F ADERS*

*Curry*

*[Handwritten signature]*

Co.

Use.

No.

Sec.

T.

R.

County Barber Elev. 1884 RB  
 Sec. 5 Twp. 31S Rge. 15W 1872  
 Company Jones, Shelburne & Farmer  
 Farm Name Moad No. 1

TOPS	DEPTH	LOG	DATUM	Loc. in Sec.
Anb.				NE NE NW
TP.				CSO - FO
H.	3832	3829		(N $\frac{1}{2}$ NW $\frac{1}{4}$ )
Tr.				Geol.
Dg.	3879	3872		Co.
Bl.		4008		Contr.
L.	4025	4034		rig #5
K.C. Massey	4470	4470		Pool
B.K.C.				W.C.
Ce.				
C.				
M.	4564	4580		
M.				
K.				
Mz.	4634	4641		
Mp.				
V.	4638	4645		
S.	4797	4810		
S.				
A.	4885	4898		
R.				
Pe.				
G.				
TD.	4920	4933		

ABANDONED  
 JUL 18 1956

Date Comm. 6-17-56

8" 835 w/350; D 900 JUL 27 '56

DST 3881-91 30" rec 10' Md  
 90 120"  $\emptyset$  3891 JUL 3 '56 DST 4435  
 -4510 1hr rec 30' Md y oil + 120"  
 o.c.m. 460 120"  $\emptyset$  4590 JUL 11 '56  
 S.L.M. 13' correction JUL 18 '56 ST PKY"  
 DST 4636-60 cr. 1hr rec 30' Md  
 BHP 0 DST 4663-4700 cr 1hr 3300  
 SW BHP 1700/20" DST 4788

4805 1 hr sec 5' Md BHP  
0/20"

DEA

5 31-15 ne ne mo