
FORM 51

Harper KANSAS

Section 5 Township 31 Range 8W

Well No. 1 Kennedy

Company Frank Purcell et al

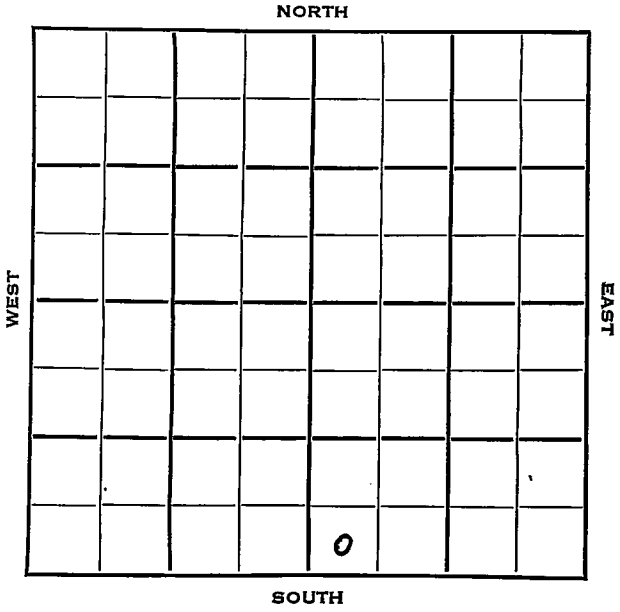

Harper KANSAS

SEC.	TWP.	R.
5	31	8 W

WELL NO.

1 Kennedy FARM
COMPANY

Frank Purcell et al
CONTRACTOR

H & H Drlg.


_____ Ft. from N. Line

330 Ft. from S. Line

_____ Ft. from E. Line

330 Ft. from W. Line

SW SW SE

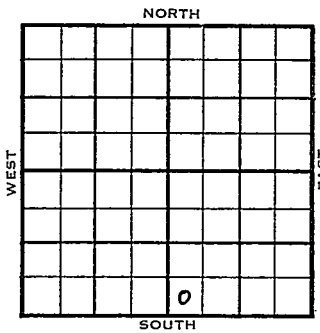

1954	ELEVATION 1664' REPORT
3/3	Spud 2-27-54 8" @ 187 Drlg. 1819'
3/10	KC 3623' Drlg 3946'
3/17	Drlg 4322'
3/24	Miss 4376' RTD 4420' 5" @ 4410' CO 4420' 2½ boph 4 hrs.
4/7	Spud 2-27-54 Oil well TD 4420 8" @ 187 KC 3623 Miss. 4376 TD 4420 5" @ 4410 CO to 4420 2½ BOPH 4 hr. Comp. F/83 BOPD 15% wtr.

COMPLETED

4410
1664
2746

DX-78

FORM 275 FOR SALE BY KANSAS BLUE PRINT CO.


County Harper State Kansas

Sec. 5 (Blk. Twp.) 31 (Sur. Rge.) 8W Map No.

Operator Frank Purcell etal.

Well No. 1 Farm Kennedy

Elev. Location SW SW SE

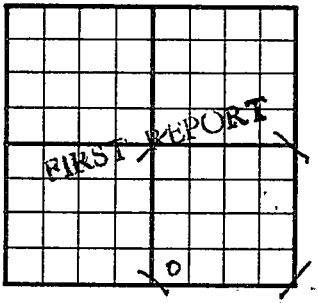

330 Ft. From S Line SE

330 Ft. From W Line Quarter

1st. Report MAR 3 1954

Completion

Remarks

H & H Drlg. - Contr.

Spudding Date 2-27-54

Drlg. Data

8" @ 187 drlg. 1819

J. G. McGEHEE

FORM 275 FOR SALE BY KANSAS BLUE PRINT CO.


County Harper State Kansas

Sec. 5 (Blk. Twp.) 31 (Sur. Rge.) 8W Map No.

Operator Frank Purcell etal.

Well No. 1 Farm Kennedy

Elev. 1664 Location SW SW SE

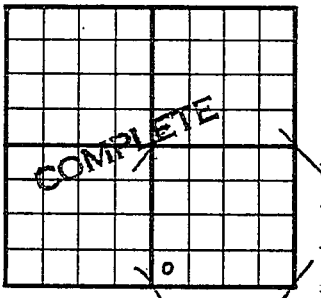

330 Ft. From S Line SE

330 Ft. From W Line Quarter

1st. Report

Completion APR 7 1954

Remarks

H & H Drlg. - Contr.

Spudding Date 2-27-54

Drlg. Data Oil well TD 4420

8" @ 187 KC 3623 Miss. 4376

TD 4420 5" @ 4410 CO to 4420

2½ boph 4 hr. Comp. F/ 83 bopd 15% wtr.

J. G. McGEHEE