


Kenneth

Section 5 Township 31 Range 9W

Well No. #1 Cox

Company Weller et al

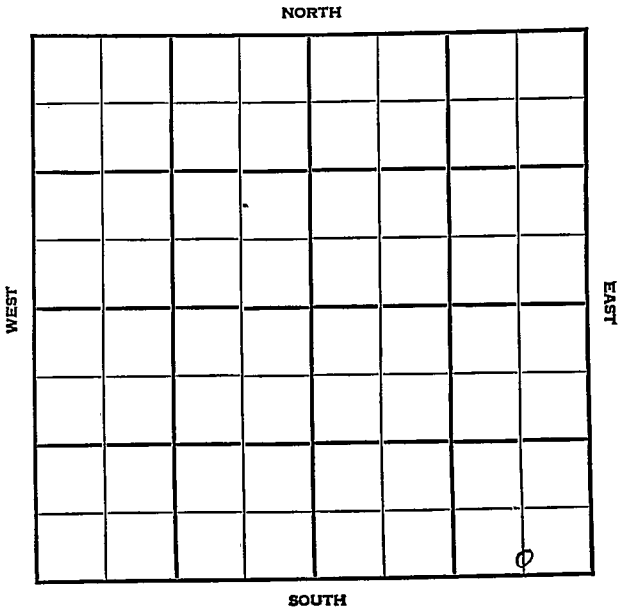

KANSAS Harper

Sec. 5 Twp. 31 R. 9W

Well No. #1 Cox Farm

Weller et al Company

Wildcat


 Ft. from N. Line

336 Ft. from S. Line

660 Ft. from E. Line

 Ft. from W. Line

C S L SE SE

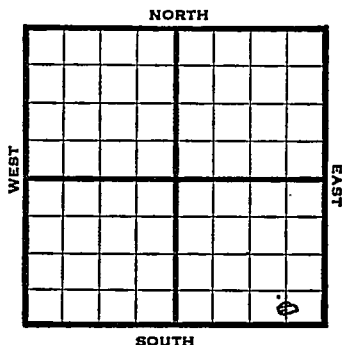

1947

Elev. 1691 REPORT

11/19 RUR

11/25 8" @ 230'
Drlg. 2750'

12/3 Lansing 3749'
Drlg. 4028'

12/10 Mississippi 4447
Drlg. 4505'

12/17 Viola 4730' Simpson 4799'

12/23 Arb. 4927'
TD 4964'

4799
1691
3108

4447
1691
2756

ABANDONED

Map No. _____ Sec. 5 Twp. 31 R. 9W

Well No. 1 Cox

Weller et al. Company

-IRST REPORT

Contractor

C S L SE SE


SECTION PLAT

_____ Ft. from N. Line

336 Ft. from S. Line

660 Ft. from E. Line

_____ Ft. from W. Line

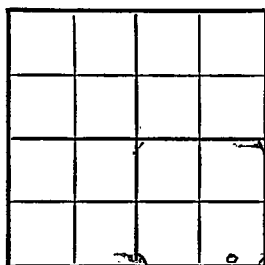

Harper County

Location _____

Rig up _____

Drilling and Remarks:

R U R

RECORD

Cased _____ in., _____ ft.

Sand _____

Gas _____

Oil _____

Total Depth _____

PRODUCTION

1st 24 hrs. Nat. _____

1st 24 hrs. after shot _____

Gas _____ Cu. Ft.

Dry Hole _____

Abandoned _____

Date

NOV 1 9 1947

19

S. J. LEWIS

Scout

Map No. 33 Sec. 5 Twp. 31 R. 9WWell No. 1 Cox


Weller et al.

Company

ABANDONED

Contractor

C S L SE SE

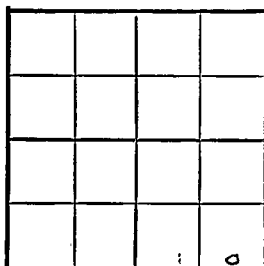E1/69/
SECTION PLAT Ft. from N. Line336 Ft. from S. Line660 Ft. from E. Line Ft. from W. LineHarper CountyLocation Rig up

Drilling and Remarks:

CR 4827

RECORD

Cased in., ft.Sand Gas Oil Total Depth 4964

PRODUCTION

1st 24 hrs. Nat. 1st 24 hrs. after shot Gas Cu. Ft.Dry Hole Abandoned

Date

DEC 23 1947 19S. J. LEWIS

Scout