



AUG 28 1985

STATE CORPORATION COMMISSION OF KANSAS
OIL & GAS CONSERVATION DIVISION

WELL COMPLETION OR RECOMPLETION FORM
ACO-1 WELL HISTORY

DESCRIPTION OF WELL AND LEASE

Operator: License # 5041
Name Ram Petroleum Corporation
Address 800 KSB&T Building
City/State/Zip Wichita, KS 67202

Purchaser.....

Operator Contact Person Jon M. Callen
Phone 265-5241

Contractor: License # 5107
Name H-30, Inc.

Wellsite Geologist Perry Hand
Phone 265-5241

Designate Type of Completion

- New Well Re-Entry Workover
- Oil SWD Temp Abd
- Gas Inj Delayed Comp.
- Dry Other (Core, Water Supply etc.)

If ONNO: old well info as follows:

Operator.....
Well Name.....
Comp. Date.....Old Total Depth.....

WELL HISTORY

Drilling Method:

- Mud Rotary Air Rotary Cable

8-1-85 8-10-85 8-11-85
Spud Date Date Reached TD Completion Date
4305'
Total Depth PBTD

Amount of Surface Pipe Set and Cemented at 261 feet
Multiple Stage Cementing Collar Used? Yes No
If yes, show depth set.....feet
If alternate 2 completion, cement circulated
from.....feet depth to.....w/.....SX cmt

API NO. 15-077-21,096.
County Harper
C SW NW Sec 10 Twp 31S Rge 6W East West

3300' Ft North from Southeast Corner of Section
4620' Ft West from Southeast Corner of Section
(Note: Locate well in section plat below)


Lease Name Meredith Well # 1 ✓

Field Name Bauer

Producing Formation.....

Elevation: Ground 1448 1453 KB.....

Section Plat

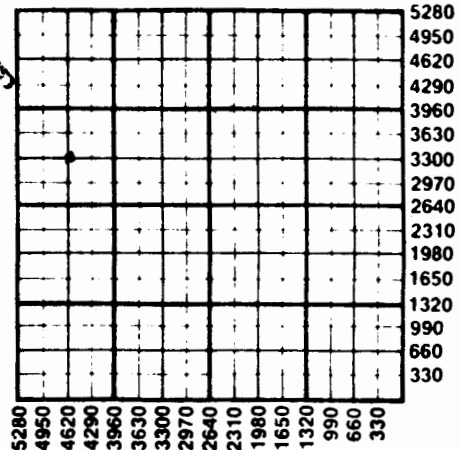

WATER SUPPLY INFORMATION

Disposition of Produced Water: Disposal Repressuring
Docket #.....

Questions on this portion of the ACO-1 call:

Water Resources Board (913) 296-3717

Source of Water:
Division of Water Resources Permit #.....

Groundwater.....Ft North from Southeast Corner (Well)Ft West from Southeast Corner of Sec Twp Rge East West

Surface Water.....Ft North from Southeast Corner (Stream, pond etc).....Ft West from Southeast Corner Sec Twp Rge East West

Other (explain) Hauled water
(purchased from city, R.W.D. #)

INSTRUCTIONS: This form shall be completed in duplicate and filed with the Kansas Corporation Commission, 200 Colorado Derby Building, Wichita, Kansas 67202, within 90 days after completion or recompletion of any well. Rule 82-3-130 and 82-3-107 apply.

Information on side two of this form will be held confidential for a period of 12 months if requested in writing and submitted with the form. See rule 82-3-107 for confidentiality in excess of 12 months.

One copy of all wireline logs and drillers time log shall be attached with this form. Submit CP-4 form with

