


KANSAS BARBER

FORM 51 5M 11-44 PETROL

Section 6 Township 31 S Range 13 W

Well No. #1 Gant

Company DRILLER'S GAS

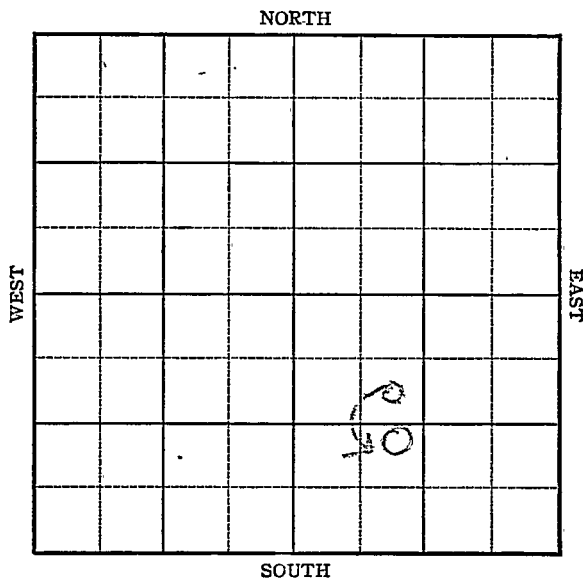

KANSAS Barber County

Sec. 6 Twp. 31 R. 13W

Well No. #1 Gant Farm

Driller's Gas Company

Wildcat'

~~990~~ Ft. from N. Line


990 Ft. from S. Line

_____ Ft. from E. Line

990 Ft. from W. Line

~~NE SW SE~~

~~SE NW SE~~ Elev. 1790

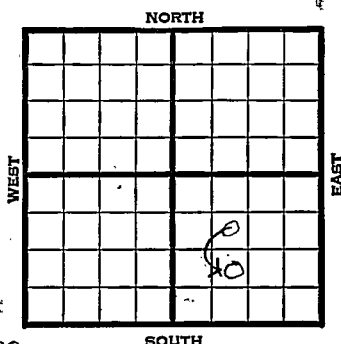

1945

REPORT

4/11	Location	
4/20	Surface hole	
4/27	10" @ 770	
	Drlg. 942	
5/3	Drlg. 2820	
5/10	Drlg. 3720	
5/17	Lans	3916
	Cong	4417
	Miss	4424
	Kind	4471
	Drlg. 4494	
5/24	Viola	4538
	Simp sd	4673
	Arb	4743
	TD 4793	
5/31	5" @ 4678' RUST	
	" " " " "	
6/8	11 shots 4532-35 - 1200' oil & water	
6/14	1000 acid	
6/21	Plug 4150 WOC	
6/28	2000 acid	
	1000,000 GAS	
7/3	" " "	
7/11	" " "	
7/18	Arb. 4743	
	5" @ 4678	
	16 shots 4532-4537	
	17 shots 3875-3892	
	TD 4793'	
	3000 acid.	

ABANDONED

Kansas

Pool Name WildcatMap No. 93 Sec. 6 Twp. 31 R. 13WWell No. 1 Gant

Driller's Gas _____ Company

FIRST REPORT

Contractor _____


SE NW SE

SECTION PLAT

990 Ft. from N. Line

_____ Ft. from S. Line

_____ Ft. from E. Line

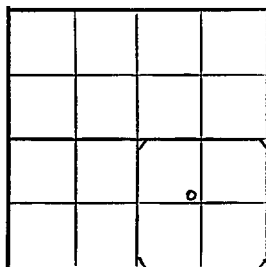990 Ft. from W. Line

Barber

Location X

Rig up _____

Drilling and Remarks:

RECORD

Cased _____ in., _____ ft.

Sand _____

Gas _____

Oil _____

Total Depth _____

PRODUCTION

1st 24 hrs. Nat. _____

1st 24 hrs. after shot _____

Gas _____ Cu. Ft.

Dry Hole _____

Abandoned _____

Date

APR 1 1 1945 19

S. J. LEWIS Scout

Kansas Pool Name WildcatMap No. 73 Sec. 6 Twp. 31 R. 13WWell No. 1 GantDrillers Gas

Company

CORRECTION

Contractor

NE SW SE

SECTION PLAT

		0	

Ft. from N. Line

990 Ft. from S. Line

Ft. from E. Line

990 Ft. from W. LineBarber County

Location

Rig up

Drilling and Remarks:

reported
SE NW SE

RECORD

Cased _____ in., _____ ft.

Sand _____

Gas _____

Oil _____

Total Depth _____

PRODUCTION

1st 24 hrs. Nat. _____

1st 24 hrs. after shot _____

Gas _____ Cu. Ft.

Dry Hole _____

Abandoned _____

Date

MAY 29 1945 19S. J. LEWIS

Scout

Pool Name Wildcat**KANSAS** KansasMap No. Map Sec. 6 Twp. 31 R. 13WWell No. 1 Gant

Driller's Gas _____ Company

ABANDONED

Contractor

NE SW SE

E 11790
SECTION PLAT

		o	

_____ Ft. from N. Line

990 Ft. from S. Line

_____ Ft. from E. Line

990 Ft. from W. Line

Barber County

Location _____

Rig up _____

Drilling and Remarks:

Cor 47435' C 467816 x 40 to 4532-3718 " 3825-923000 acid**RECORD**

Cased _____ in., _____ ft.

Sand _____

Gas _____

Oil _____

Total Depth 4283**PRODUCTION**

1st 24 hrs. Nat. _____

1st 24 hrs. after shot _____

Gas _____ Cu. Ft.

Dry Hole _____

Abandoned _____

Date

JUL 1 8 1945

19

S. J. LEWIS

Scout