
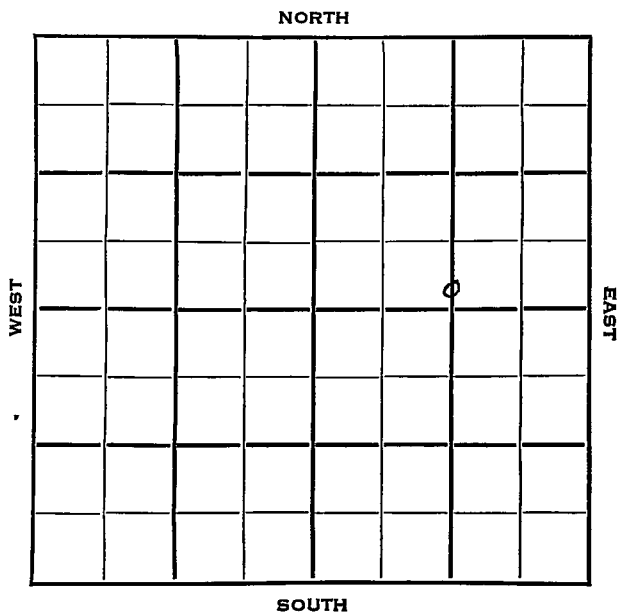


Section 6 Township 31 Range 34WWell No. 1 Day UnitCompany Texas Company

Seward

Sec. 6 Twp. 31 R. 34WWell No. 1 Day Unit FarmTexas Company CompanyNoble Drlg. Co. - Contr. Contractor Ft. from N. Line330 Ft. from S. Line1320 Ft. from E. Line Ft. from W. Line

C S/2 S/2 NE

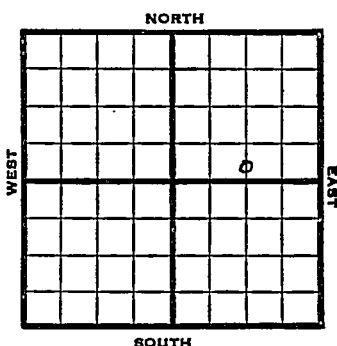

1953 Elev. 2886' REPORT

1/7 Spudding Date 1/5/53
10" @ 6191/22 TD 2655
7" @ 2654
CO 2650
152/2606-44, 80/2558-78
76/2521-40, 88/2488-25101/29 Her 2484' Kr 2519' Win 2556'
Ft. Riley 2602'

2/5 Swedge Csg.

2/12 "

2/19 "

2/26 CO 2655 set 5" @ 2330 24,000A

3/4 Spud 1-5-53
Gas Well
TD 2655
10" @ 619
Her 2484, Kri 2519, Win 2556,
Ft. Riley 2602
TD 2655
7" @ 2654
CO to 2650 152/2606-44, 80/
2558-78, 76/2521-40, 88/2488-
2510, CO to 2655
5" @ 2330 24000A
Comp. 5,800,000 gas**COMPLETED**

County Seward State KansasSec. 6 (Blk.) (31) (Sur.) 34W Map No.Operator Texas CompanyWell No. 1 Farm Day UnitElev. Location C S $\frac{1}{2}$ S $\frac{1}{2}$ NE

330 Ft. From S Line NE1320 Ft. From E Line Quarter1st. Report JAN 7 1953


Completion

Remarks

Noble Drlg. - Contr.Spudding Date 1-5-53

Drlg. Data

10" @ 619

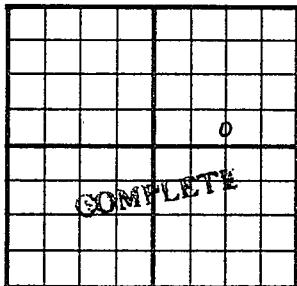County Seward State KansasSec. 6 (Blk.
Twp.) 31 (Sur.
Rge.) 34W Map No.Operator Texas CompanyWell No. 1 Farm Day UnitElev. 2886 Location C S $\frac{1}{2}$ S $\frac{1}{2}$ NE330 Ft. From S Line NE1320 Ft. From E Line Quarter1st. ReportCompletion MAR 4 1953RemarksNoble Drlg. - Contr.Spudding Date 1-5-53Drlg. Data Gas well TD 265510" @ 619 Her. 2484 Kri. 2519Win. 2556 Ft. Riley 2602 TD 26557" @ 2654 Coto 2650 152/ 2606-4480/ 2558-78 76/ 2521-40 88/ 2488-2510C0 to 2655 5" @ 2.330 24000 AComp. 5,800,000-gas