


KANSAS

Seward

Section 6 Township 31 Range 33W
34Well No. 1 Conver "B"Company Cities Service

Hugoton

NORTH

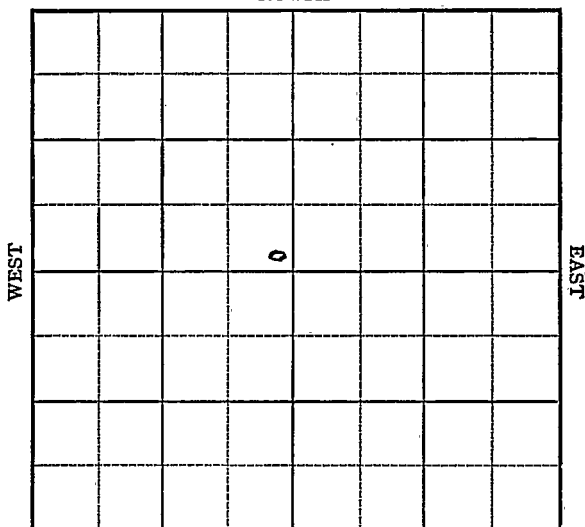

SOUTH

Seward

KANSAS

Sec. 6 Twp. 31 R. 33W

Well No. #1 Conver "B" Farm

Cities Service

Company

Hugoton Pool (Lohman & Johnson, Cont.)

NORTH

 Ft. from N. Line


100'

 Ft. from S. Line

100'

 Ft. from E. Line

 Ft. from W. Line

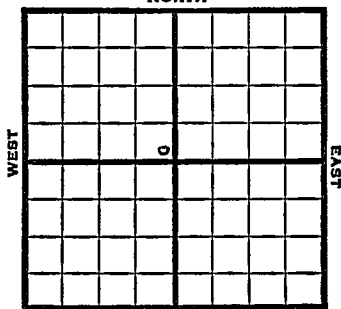

SOUTH

SE NW

1949 Elev 2941' REPORT

6/15 RUR
6/21 8" @ 640'
Drlg. 2502'
6/28 TD 2760'
5" @ 2759'
7/6 140 shots 2712-40
2000 acid
7/12 340 shots 2567-2684
32,500 acid
7/20 "
7/27 "
8/3 TD 2760'
5" @ 2759'
Perf 32500 acid
30,400,000 Gas
412# R Pr.
Comp
COMPLETED

Seward County Kansas StateMap No. _____ Sec. 6 Twp. 31 R. 33WWell No. 1 Conver "B"Cities Service CompanyLohman & Johnson ContractorFIRST REPORT
SECTION PLAT

SE NW

 Ft. from N. Line100 Ft. from S. Line100 Ft. from E. Line Ft. from W. Line

Hugoton Pool

Remarks:

R U R

Date
JUN 15 1949Scout S. J. LEWIS

Kansas

Hugoton Pool

Map No. ✓ Sec. 6 Twp. 31 R. 33WWell No. 1 Conver "B"

Cities Service Company


COMPLETE

Contractor

SE NW

E12841

SECTION PLAT

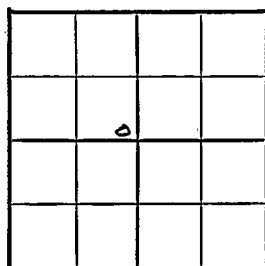 Ft. from N. Line100 Ft. from S. Line100 Ft. from E. Line Ft. from W. Line

Seward County

Location Rig up

Drilling and Remarks:

5" Cased

Perf.

22500 acid

30,400,000 gal.

412 R/A

RECORD

Cased in., ft.Sand Gas Oil Total Depth 2260

PRODUCTION

1st 24 hrs. Nat. 1st 24 hrs. after shot Gas Cu. Ft.Dry Hole Abandoned

Date

AUG 3 1949 19

S. J. LEWIS

Scout