

Section 6 Township 31 Range 19W

Well No. 1 Winkler

Company Stanolind

Wildcat

NORTH

WEST

EAST

SOUTH

Sec. 6 Twp. 31 R. 19W

Well No. #1 Winkler Farm

Stanolind Company

Wildcat


330 Ft. from N. Line

 Ft. from S. Line

330 Ft. from E. Line

 Ft. from W. Line

NE NW

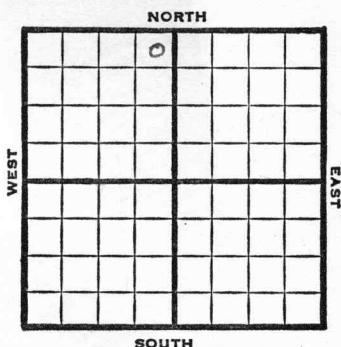

1947 Elev. 2145' REPORT

7/23	RUR
7/29	13" @ 195' Drlg 1073'
8/6	8" @ 1090' Drlg 2630'
8/13	Drlg. 3776'
8/20	Lansing 4382' Drlg 4449'
8/27	Drlg. 4853'
9/3	Mississippi 5018' Drlg. 5135'
9/10	Drlg. 5482'
9/17	Drlg. 5660'
9/24	Viola 5694 Simpson 5895' Sand 5949' Drlg. 5962'

OVER

1947

10/1 Arbuckle 5980
TD 6036

ABANDONED

Kansas


Map No. _____ Sec. 6 Twp. 31 R. 19WWell No. 1 Winkler

Stanolind _____ Company

FIRST REPORT _____ Contractor

NE NW

SECTION PLAT

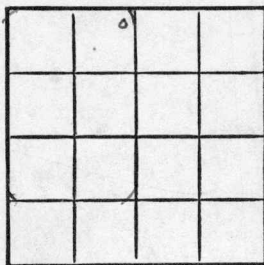330 Ft. from N. Line

_____ Ft. from S. Line

330 Ft. from E. Line

_____ Ft. from W. Line

Comanche County

Location _____

Rig up _____

Drilling and Remarks:

R U R

RECORD

Cased _____ in., _____ ft.

Sand _____

Gas _____

Oil _____

Total Depth _____

PRODUCTION

1st 24 hrs. Nat. _____

1st 24 hrs. after shot _____

Gas _____ Cu. Ft.

Dry Hole _____

Abandoned _____

Date

JUL 23 1947 19


S. J. LEWIS

Scout

Company

Contractor

SECTION PLAT

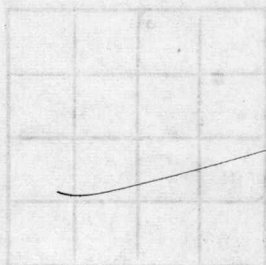





RECORD

Misc. Small Maps

Cards 243

Tracing

France Map

Scarborough Map

Fierce Map

Geological Dept.

Pierce Plat Book

Map No. 95 Sec. 6 Twp. 31 R. 19W

Well No. 1 Winkler

Stanolind Company

ABANDONED Contractor

NE NW


E 1/2 145
SECTION PLAT

330 Ft. from N. Line

 Ft. from S. Line

330 Ft. from E. Line

 Ft. from W. Line

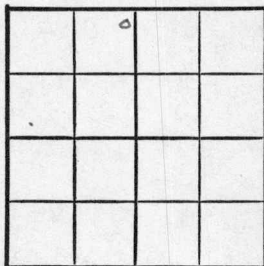

Comanche County

Location

Rig up

Drilling and Remarks:

CE 85980

RECORD

Cased in., ft.

Sand

Gas

Oil

Total Depth 6436

PRODUCTION

1st 24 hrs. Nat.

1st 24 hrs. after shot

Gas Cu. Ft.

Dry Hole

Abandoned

Date

OCT 1 1947 19

S. J. LEWIS Scout


Map No. _____ Sec. _____ Twp. _____ R. _____

Well No. _____

Company _____

Geologist _____

SECTION PLAT

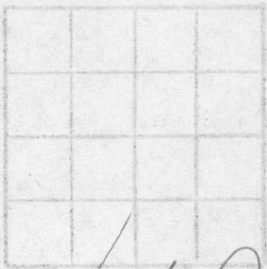

_____ ft. from N. line

_____ ft. from S. line

_____ ft. from E. line

_____ ft. from W. line

[Handwritten signature]

RECORD

_____ ft. _____ in _____
_____ Sand _____
_____ Gas _____
_____ Oil _____

Location _____

_____ ft. up _____

Drilling and Remarks _____

[Handwritten signature: Elaine]
Misc. Small Maps _____
Cards _____
Tracing _____
France Map _____
Pierce Map _____
Pierce Map _____
Cock, Cal Dept _____
Pierce Flat Dept _____

Date _____