

Sumner

KANSAS


SECTION 6 TOWNSHIP 31S RANGE 1W

WELL NO. #1 Utt "A"

COMPANY Beardmore Drlg.

NORTH

C S/2 SW SW

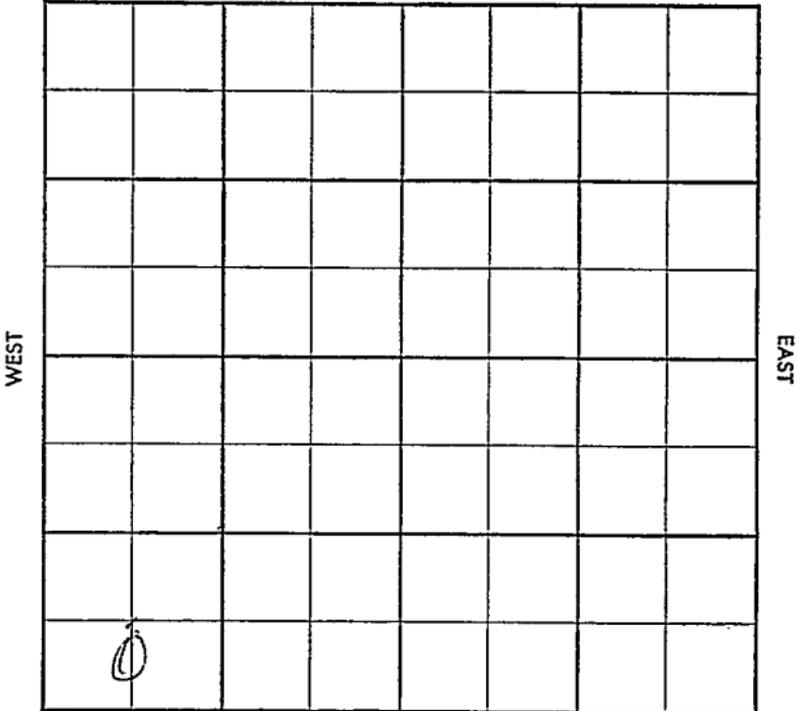

SOUTH

Twp.  Pool   
 Co.  Feet

S-513-B

County Sunney Elev. \_\_\_\_\_  
 Sec. 6 Twp. 31 Rge. 1W  
 Company Beardmore Drlg.  
 Farm Name Utt "A" No. 1

TOPS	DEPTH	LOG	DATUM
Anh.			
Tp.			
H.			
Tr.			
Dg.			
B.L.			
L.			
K.C.			
B.K.C.			
Ce.			
C.			
M.			
M.			
K.			
Mz.			
Mq.			
V.			
S.			
S.			
A.			
R.			
Pf.			
G.			
T.D.			

Loc. in Sec. C S $\frac{1}{2}$  SW SW  
 Geol. \_\_\_\_\_  
 Contr. Co. tools  
 Pool SE Anson

FIRST REPORT  
 JUN 25 '58

Date Comm. Pan-American - FO  
M I R

Co.  
 Use.  
 No.  
 Sec.  
 T.  
 R.

Top  Pool   
 Co.  Feet  No

6-513-B

 Sec. 6 Twp. 31 Rge. 1W  
 Company Beardmore Drl. Co.  
 Farm Name Utt "A" No. 1

TOPS	DEPTH	LOG	DATUM
Anh.			
Tp.			
H.			
Tr.			
Dg.			
B.L.			
L.	<u>3046</u>		
K.C.		<u>3049</u>	
B.K.C.			
Ce.			
C.			
M.	<u>A</u>	<u>3697</u>	<u>3696</u>
M.	<u>Li</u>	<u>3703</u>	
K.			
Mz.			
Mq.			
V.			
S.			
A.			
R.			
Pf.			
G.			
T.D.	<u>3725</u>		

Loc. in Sec. C S 1/4 SW SW  
 Geol. \_\_\_\_\_  
 Contr. Co. tools  
 Pool SE Anson

**COMPLETE**  
 AUG 13 '58

Date Comm. 6-24-58 Non-American - FO  
 N I R JUL 2 '58 8" 211/140 Lost Hole  
Skid 50' N JUL 9 '58 Ø 3230 9" 45/1325  
 JUL 16 '58 Core 3714 - 25 11' Li + dolo  
stair per vert Evac DST 3711 - 25  
10" 350' gem sso LBHP 1410  
log 5" 3711/150 JUL 23 '58 Co 3725  
\$ 3 1/2 Boph + trw 12 hrs DD  
3726 TD (E) F107130 ph + trw  
10 hrs JUL 30 '58 AUG 6 '58 AUG 13 '58  
PHY F10 160 Bopd + trw 42° 9'