


Summer KANSAS

Section 6 Township 31 Range 3W

Well No. 1 Glass

Company Aurora & Aylward

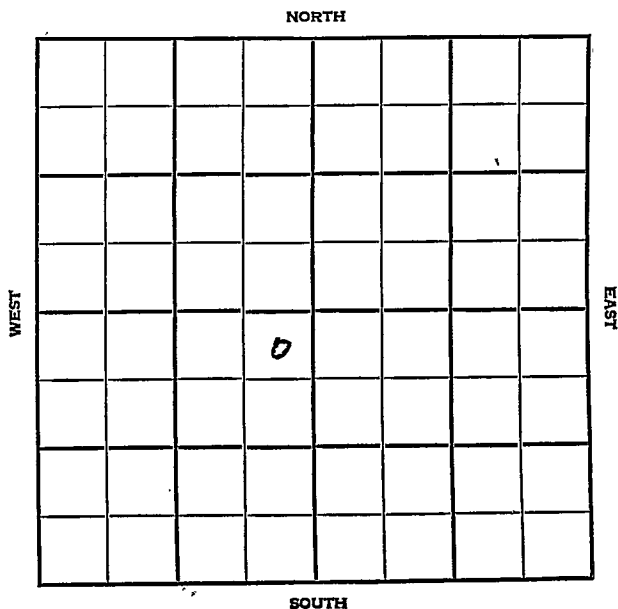

Summer

KANSAS


SEC.	TWP.	R.
6	31	3 W

WELL NO. # 1 Glass FARM

COMPANY Aurora & Aylward

CONTRACTOR Aylward Wildcat

330 Ft. from N. Line
 _____ Ft. from S. Line
 330 Ft. from E. Line
 _____ Ft. from W. Line

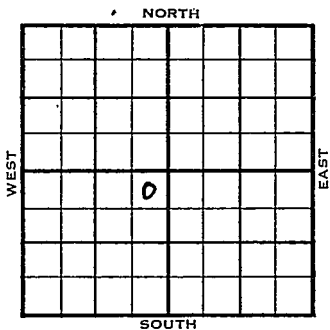

NE NE SW

Sun & Sunray - DHM

	ELEVATION	REPORT
1955	1437'	
2/16		Spud 2-12-55 8" @ 118 Drlg. 1250'
3/9		Spud 2-12-55 D & A TD 4552 8" @ 118 Stal. 3111 Lans. 3383 DST 3516-36 open 2 hr rec 30' 0 & GCM, 30' mud. 0#. B KC 2628 M arm. 3685 Cherokee 3856 Miss 4004 Chattanooga 4411 Simp 4427'. DST 4429-35 open 1 hr rec 30' MW & 40' SW 1650# Arb. 4533' TD 4552' D & A LOG TOPS; Lans 3373, Miss 4008, Simp 4414, Arb. 4524'

ABANDONED

Snout Cards

Lin 1 5m 1 Map

Lead Wall Map

Tracings

France Map

Pierce Map

Misc.

FEB 17 1955

Drig. Data

Scout Cards _____

Land Small Map _____

Land Wall Map _____

Trails _____

FFCCO Map _____

FFCCO Map _____

M _____

MAR 25 1955

Drig. Data