

Harper

KANSAS

SECTION 6 TOWNSHIP 31 RANGE 9 W

WELL NO. #1 Maude Jacobs 8" B"

COMPANY Magnolia Pet.

NORTH

						0	

WEST

EAST

SOUTH

Harper

KANSAS

SEC.	6	TWP.	31	R.	9W
------	---	------	----	----	----

WELL NO. #1 Maude Jacobs ~~121~~ "B" FARM

COMPANY Magnolia Pet.

CONTRACTOR Bass Drlg.

Rochester


\_\_\_\_\_ Ft. from N. Line

\_\_\_\_\_ Ft. from S. Line

\_\_\_\_\_ Ft. from E. Line

\_\_\_\_\_ Ft. from W. Line

SW NE NE

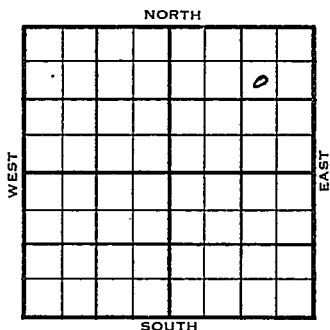

1955	ELEVATION	REPORT
	1644'	

11/9 Comm 11-5-55  
 9" @ 251/235  
 Drlg 1326

12-14 DST 4364-87 op 1 hr. rec. 70' sgcm  
 740/30"  
 5 1/2" @ 4484/200  
 CO to 4449 60/ 4370-85, viso-frac  
 F/ 285 mcfg, sq. 4370-85  
 CO 12/ 4352-55, viso-frac  
 SP 3560, 16/ 3536-40, frac  
 Temp. Abd.  
 M. 4363  
 TD 4485'

**ABANDONED**

County Hanper Elev. \_\_\_\_\_  
 Sec. 6 Twp. 31 Rge. 9W  
 Company Magnolia Pet.  
 Farm Name Maudie Jacobs "A" No. 1

TOPS	DEPTH	LOG	DATUM
Anh.			
Tp.			
H.			
Tr.			
Dg.			
Bl.			
L.			
K.C.			
B.K.C.			
Ce.			
C.			
M.			
M.			
K.			
Mz.			
Me.			
V.			
S.			
S.			
A.			
R.			
Pe.			
G.			
T.D.			

Loc. in Sec. SW NE NE  
 Geol. \_\_\_\_\_  
 Contr. Bass Drlg.  
 Pool Rochester  


NOV 9 '55  
 FIRST REPORT

Date Comm. 11-5-55  
9" @ 251/235 drlg. 1326

~~27~~

Co.  
 Lse.  
 No.  
 Sec.  
 T.  
 R.

# SCOUT TICKET DX-201

SEC.	TWP.	R.
6	31	9W

WELL NO.

**Maude Jacobs "B"** FARM  
COMPANY

**Magnolia Pet.**  
CONTRACTOR

## CORRECTION


SW NE NE

990 FT. FROM N. LINE

FT. FROM S. LINE

990 FT. FORM E. LINE

FT. FROM W. LINE

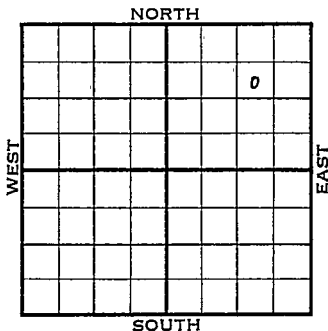

**Harper County**

LOCATION  
 RIG UP  
 DRILLING AND REMARKS:

Reported  
 Maude Jacobs "A"

RECORD

CASED	IN.,	FT.
SAND		
GAS		
OIL		
TOTAL DEPTH		

PRODUCTION

1ST 24 HRS. NAT.	
1ST 24 HRS. AFTER SHOT	
GAS	CU. FT.
DRY HOLE	
ABANDONED	

DATE	SCOUT
DEC 14 1955	

County Harper Elev. 1644  
 Sec. 6 Twp. 31 Rge. 9W  
 Company Magnolia Pet.  
 Farm Name Maude Jacobs "B" No. 1

TOPS	DEPTH	LOG	DATUM	Loc. in Sec.	
Anh.				SW NE NE	
Tr.	
H.	
Tr.	
Dg.	
Bl.	
L.				Geol.	
K.C.				Contr.	
B.K.C.				<u>Bass Drlg.</u>	
Ce.				Pool	
C.				<u>Rochester</u>	
M.	<u>4363</u>		<u>2719</u>	<table border="1"> <tr> <td></td> <td></td> <td></td> <td></td> </tr> <tr> <td></td> <td></td> <td></td> <td></td> </tr> <tr> <td></td> <td></td> <td></td> <td></td> </tr> <tr> <td></td> <td></td> <td></td> <td></td> </tr> <tr> <td></td> <td></td> <td></td> <td></td> </tr> <tr> <td></td> <td></td> <td></td> <td></td> </tr> <tr> <td></td> <td></td> <td></td> <td></td> </tr> <tr> <td></td> <td></td> <td></td> <td></td> </tr> <tr> <td></td> <td></td> <td></td> <td></td> </tr> <tr> <td></td> <td></td> <td></td> <td></td> </tr> </table>	
M.	
K.	
Mz.	
Me.	
V.	
S.	
S.	
A.	
R.	
PE.	
G.	
T.D.	<u>4485</u>	

Date Comm. 11-5-55 DEC 14 1955

9" @ 251/235 DST 4364-87 open 1 hr.

rec. 70' sgcw 740/30" 5 1/2" @ 4484/200

CO to 4449 60/ 4370-85 viso-frac

F/ 285 mcfg sq. 4370-85 CO

12/4352-55 viso-frac SP360

16/ 3536-40 frac Temp. abd.

ABANDONED