

KANSAS

Computer Inventoried

WELL COMPLETION REPORT AND
DRILLER'S LOGAPI No. 15 — 077 — 20,597
County Number

Operator

Wells Energy Corp.

Address

700 S. Colorado Blvd., Suite 454 Denver, Colo 80222

Well No.

#1

Lease Name

Joslin

Footage Location

1750 feet from (N) (S) line 2000 feet from (E) (W) line

Principal Contractor

Xplor Drilling Co.

Geologist

Bob Laymon

Spud Date

6/10/80

Date Completed

6/19/80

Total Depth

3597

P.B.T.D.

Directional Deviation

Oil and/or Gas Purchaser


S. 1 T. 31 R. 7 E. W

Loc. 1750' FNL & 2000' FWL NW

County Harper

640 Acres

N

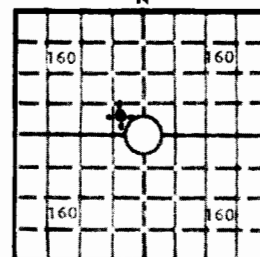

Locate well correctly

Elev.: Gr. 1566'

DF KB

CASING RECORD

Report of all strings set — surface, intermediate, production, etc.

Purpose of string	Size hole drilled	Size casing set (in O.D.)	Weight lbs/ft.	Setting depth	Type cement	Sacks	Type and percent additives
Surf.	12 1/4"	8 5/8"	28#	254'		200	

LINER RECORD

PERFORATION RECORD

Top, ft.	Bottom, ft.	Sacks cement	Shots per ft.	Size & type	Depth interval

TUBING RECORD

Size	Setting depth	Packer set at			


ACID, FRACTURE, SHOT, CEMENT SQUEEZE RECORD

Amount and kind of material used	Depth interval treated

INITIAL PRODUCTION

Date of first production		Producing method (flowing, pumping, gas lift, etc.)			
Dry hole					
RATE OF PRODUCTION PER 24 HOURS	Oil	Gas	Water	Gas-oil ratio	
	bbls.	MCF	bbls.	CFPB	
Disposition of gas (vented, used on lease or sold)			Producing interval (s)		

INSTRUCTIONS: As provided in KCC Rule 82-2-125, within 90 days after completion of a well, one completed copy of this Drillers Log shall be transmitted to the State Geological Survey of Kansas, 4150 Monroe Street, Wichita, Kansas 67209. Copies of this form are available from the Conservation Division, State Corporation Commission, 245 No. Water, Wichita, Kansas 67202. Phone AC 316-522-2206. If confidential custody is desired, please note Rule 82-2-125. Drillers Logs will be on open file in the Oil and Gas Division, State Geological Survey of Kansas, Lawrence, Kansas 66044.

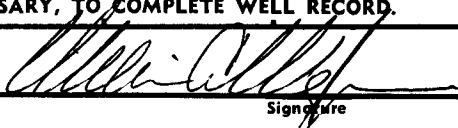Operator		DESIGNATE TYPE OF COMP.: OIL, GAS, DRY HOLE, SWDW, ETC.:	
Well No. 1	Lease Name Joslin	Dry Hole	
S <u>1</u> T <u>31</u> R <u>7</u> W			
WELL LOG Show all important zones of porosity and contents thereof; cored intervals, and all drill-stem tests, including depth interval tested, cushion used, time tool open, flowing and shut-in pressures, and recoveries.		SHOW GEOLOGICAL MARKERS, LOGS RUN, OR OTHER DESCRIPTIVE INFORMATION.	
FORMATION DESCRIPTION, CONTENTS, ETC.	TOP	BOTTOM	NAME
DST #1 3469'-3524' (Stalnaker) 30"-60"-45"-90". IF=Strong blo thruout; FF=GTS immed., 74 incr. to 86 MCFD. Rec. 150' GCM. IFP=68#-68#, FFP=54#-54#, ISIP= 1430#, FSIP=1430#. DST #2 3469'-3529' (Stalnaker) 30"-60"-45"-90". IF=Strong blo thruout; FF=GTS/TSTM. Rec. 150' GCM, 240' W. IFP=122#-150#, FFP=177#-204#, ISIP=1268#, FSIP= 1390# DST #3 2183'-2255' (Indian Cave) Rec. 1410' W, 180' M. IFP= 106#-773#, FFP=826#-815#, ISIP= 920#, FSIP=920#			Ran Dual Ind. Laterolog & G/R Neut- Dens. w/ caliper Chase-Herington 1420+154 Wabaunsee 2280-706 Howard 2612-1038 Heebner 3243-1669 Stalnaker sand 3519-1945
USE ADDITIONAL SHEETS, IF NECESSARY, TO COMPLETE WELL RECORD.			
Date Received	 		

COMPANY Wells Energy Corporation

SEC. 1 T. 31 R. 7W
LOC. 1750' FNL & 2000' FWL

FARM Joslin NO. 1

COUNTY Harper

ROTARY TOTAL DEPTH 3,579'
COMM. June 10, 1980 COMP. June 18, 1980
CONTRACTOR H-30, INC. (Rig #3)
ISSUED July 3, 1980

CASING

10 3/4"
8 5/8" Set at 254' cemented w/200 sxs cement
5 1/2"
4 1/2"

ELEVATION 1,574' K.B.

FIGURES INDICATE BOTTOM OF FORMATIONS

Sand	55'
Red Bed and Shale	1,140'
Lime and Shale	1,515'
Shale and Lime	1,735'
Lime and Shale	3,524'
Lime	3,529'
Lime and Shale	3,579'
Rotary Total Depth	3,579'

I hereby certify the above and foregoing to be
a true and correct log of the above described
well as shown by the drilling reports.

H-30, INC.

Dean Britting
Dean Britting

State of Kansas)
County of Sedgwick) ss:

Subscribed and Sworn to before me a Notary Public
in and for said county and state this 3rd day of