

KANSAS DRILLERS LOG

Computer Inventoried
State Geological Survey
WICHITA, BRANCH

API No. 15 — 077 — 20,353
County Number

Operator

Texas Oil & Gas Corp

Address

Suite 450 200 W. Douglas Wichita, Kansas 67202

Well No.

#1

Lease Name

Mount

Footage Location

1650' feet from (N) line 990' feet from (E) line

Principal Contractor

Xplor Drilling Co.

Geologist

Gary Holstin

Spud Date

3-28-76

Total Depth

4740'

P.B.T.D.

N/A

Date Completed

4-8-76

Oil Purchaser

N/A


S. 1 T. 31 R. 7W

Loc. 1650' FSL & 990' FWL

County Harper

640 Acres

N

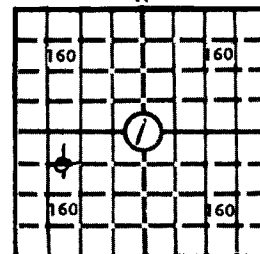

Locate well correctly

1584'

Elev.: Gr.

DF 1589' KB 1592'

CASING RECORD

Report of all strings set — surface, intermediate, production, etc.

Purpose of string	Size hole drilled	Size casing set (in O.D.)	Weight lbs/ft.	Setting depth	Type cement	Sacks	Type and percent additives
Surface	12 1/4"	8 5/8"	20#	204'	Common	250	2% Gel 3% CaCl

LINER RECORD

Top, ft.	Bottom, ft.	Sacks cement
N/A	N/A	N/A

PERFORATION RECORD

Shots per ft.	Size & type	Depth interval
N/A		

TUBING RECORD

Size	Setting depth	Packer set at
N/A	N/A	N/A

ACID, FRACTURE, SHOT, CEMENT SQUEEZE RECORD

Amount and kind of material used	Depth interval treated
N/A	

INITIAL PRODUCTION

Date of first production	Producing method (flowing, pumping, gas lift, etc.)
N/A	N/A
RATE OF PRODUCTION PER 24 HOURS	Oil N/A bbls. Gas N/A MCF Water N/A bbls. Gas-oil ratio N/A CFPB
Disposition of gas (vented, used on lease or sold)	Producing interval(s)
N/A	N/A

INSTRUCTIONS: As provided in KCC Rule 82-2-125, within 90 days after completion of a well, one completed copy of this Drillers Log shall be transmitted to the State Geological Survey of Kansas, 4150 Monroe Street, Wichita, Kansas 67209. Copies of this form are available from the Conservation Division, State Corporation Commission, 3830 So. Meridian (P.O. Box 17027), Wichita, Kansas 66217. Phone AC 316-522-2206. If confidential custody desired, please note Rule 82-2-125. Drillers Logs will be on open file in the Oil and Gas Division, State Geological Survey of Kansas, Lawrence, Kansas 14.

Texas Oil & Gas Corp.

Well No.	Lease Name	
1	Mount	Dry Hole

S 1 T 31 S R 7 E
W

WELL LOG


Show all important zones of porosity and contents thereof; cored intervals, and all drill-stem tests, including depth interval tested, cushion used, time tool open, flowing and shut-in pressures, and recoveries.

SHOW GEOLOGICAL MARKERS, LOGS RUN,
OR OTHER DESCRIPTIVE INFORMATION.

FORMATION DESCRIPTION, CONTENTS, ETC.	TOP	BOTTOM	NAME	DEPTH
Herrington	1456	+136		
Winfield	1512	+80		
Towanda	1576	+16		
Fort Riley	1626	-34		
Florence	1670	-76		
Indian Cave	2232	-640		
Indian Cave Sand	2244	-652		
Stotler	2438	-846		
Tarkio	2486	-894		
Howard	2720	-1128		
Topeka	2888	-1296		
Heebner	3272	-1680		
Iatan	3484	-1892		
Stalnaker Sand	3540	-1948		
RTD	4740	-3148		
DST #1 3484-3557' (Stalnaker). IFP/30": 166-270#, opened up with strong blow, GTS in 35", GVTSTM. ISIP/60": 1350#. FFP/45": 332-468#, strong blow w/GVTSTM. FSIP/90": 1350#. Rec 60' mud, 180' wtry mud, 600' wtr. IHP 1768#, FHP 1768#, 130 degrees BHT.				
DST #2 4319-50' (mis-run)				
DST #3 4313-50' (mis-run)				
DST #4 4344-50' (mis-run)				
DST #5 4344-60' (Miss.). IFP/30": 52-83#, opened with strong blow. ISIP/60": 1402#. FFP/60": 124-156#, strong blow. FSIP/120": 1485#. Strong blow throughout test, GTS 45" after FSI. Rec 90' O&GCM, 70' mdy wtr w/oil scum & 180' wtr.				
DST #6 4365-4483' (Miss.). IFP/30": 562-1423#, opened with strong blow. ISIP/60": 1558#. FFP/45": 1475-1558#, strong blow. FSIP/90": 1558#. Rec 3100' wtr.				

USE ADDITIONAL SHEETS, IF NECESSARY, TO COMPLETE WELL RECORD.

Date Received

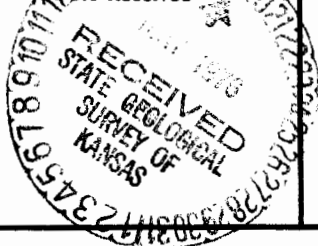

William C. Wells, Jr. Signature

District Manager

Title

April 19, 1976

Date