2-31-7W

TYPE

AFFIDAVIT OF COMPLETION FORM ACO-1 WELL HISTORY

SIDE ONE ★

Two (2) copies of this form shall be filed with the Kansas Corporation Commission, 200 Colorado Derby Building, Wichita, Kansas 67202, within thirty (30) days after the completion of a well, regardless of how the well was completed.

Attach separate letter of request if the information is to be held confidential. If confidential, only file one copy. Information on Side One will be of public record and Side Two will then be held confidential.

Applications must be made on dual completion, commingling, salt water disposal, injection and temporarily abandoned wells.

Attach one copy only wireline logs (i.e. electrical log, sonic log, gamma ray neutron log, etc.). (Rules 82-2-105 & 82-2-125) KCC# (316) 263-3238.

LICENSE # _____ EXPIRATION DATE _____

OPERATOR Eldon J. Schierling API NO. 15-077-20,800

ADDRESS 830 Sutton Place, COUNTY Harper

Wichita, Kansas 67202 FIELD Duquoin

** CONTACT PERSON Eldon J. Schierling PROD. FORMATION Mississippian

PHONE 267-0042

PURCHASER Eldon J. Schierling LEASE Williams

ADDRESS 830 Sutton Place WELL NO. 2

Wichita, Ks. 67202 WELL LOCATION 100' SE of NE NE NW

DRILLING CONTRACTOR Gabbert-Jones, Inc. 240 Ft. from East Line and

ADDRESS 830 Sutton Place 400 Ft. from North Line of

Wichita, Kansas 67202 the NW (Qtr.) SEC 2 TWP 31S RGE 7W.

PLUGGING CONTRACTOR Allied Cementing Co., Inc.

ADDRESS P.O. Box 31

Russell, Kansas 67665

TOTAL DEPTH 4397 PBTD _____


SPUD DATE 4-13-82 DATE COMPLETED 4-20-82

ELEV: GR 1602 DF 1605 KB 1608

DRILLED WITH (~~CABLE~~) (ROTARY) (~~AIR~~) TOOLS.

DOCKET NO. OF DISPOSAL OR REPRESSURING WELL BEING USED TO DISPOSE OF WATER FROM THIS LEASE _____.

WELL PLAT

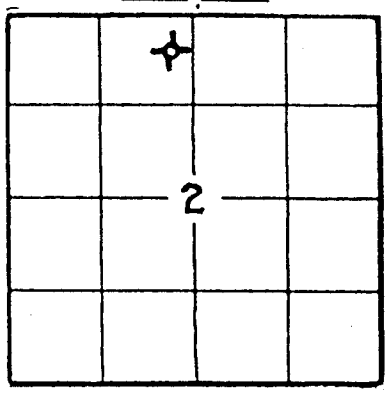

(Office Use Only)
KCC ____
KGS ✓
SWD/REP ____
PLG. ____

Amount of surface pipe set and cemented 304' DV Tool Used? No.

THIS AFFIDAVIT APPLIES TO: (Circle ONE) - Oil, Gas, Shut-in Gas, (Dry) Disposal, Injection, Temporarily Abandoned, OWWO. Other _____.

ALL REQUIREMENTS OF THE STATUTES, RULES AND REGULATIONS PROMULGATED TO REGULATE THE OIL AND GAS INDUSTRY HAVE BEEN FULLY COMPLIED WITH.

A F F I D A V I T

RECEIVED
STATE CORPORATION COMMISSION
JUN - 4 1982
CONSERVATION DIVISION
Wichita, Kansas

Eldon J. Schierling, being of lawful age, hereby certifies that:

I am the Affiant, and I am familiar with the contents of the foregoing Affidavit. The statements and allegations contained therein are true and correct.

Eldon J. Schierling
(Name)

State Geological Survey
WICHITA BRANCH

P1

SIDE TWO

ACO-1 WELL HISTORY

OPERATOR Eldon J. Schierling LEASE Williams SEC. 2 TWP 31S RGE. 7W

FILL IN WELL LOG AS REQUIRED:

Show all important zones of porosity and contents thereof; cored intervals, and all drill-stem tests, including depth interval tested, cushion used, time tool open, flowing and shut-in pressures, and recoveries.			SHOW GEOLOGICAL MARKERS, LOGS RUN, OR OTHER DESCRIPTIVE INFORMATION.	
FORMATION DESCRIPTION, CONTENTS, ETC.	TOP	BOTTOM	NAME	DEPTH
DST #1	4371	4382		
DST #2	4382	4397		
Heebner	3306			
Stalnaker	3640			
Kansas City	3821			
Swope	3959			
Hertha	3991			
B/ KC	4075			
Mississippian	4369			
RTD	4397			

Report of all strings set — surface, intermediate, production, etc. CASING RECORD (~~New~~) or (Used)

Purpose of string	Size hole drilled	Size casing set (in O.D.)	Weight lbs/ft.	Setting depth	Type cement	Sacks	Type and percent additives
Surface	12 1/4	8 5/8	24	304'	Common	225	3%CC - 2% Gel

LINER RECORD

Top, ft.	Bottom, ft.	Sacks cement

TUBING RECORD

Size	Setting depth	Packer set at

PERFORATION RECORD

Shots per ft.	Size & type	Depth interval

ACID, FRACTURE, SHOT, CEMENT SQUEEZE RECORD