


Section 7 Township 31 Range 14-W

Well No. #3, Oldfather

Company Sinclair-Prairie

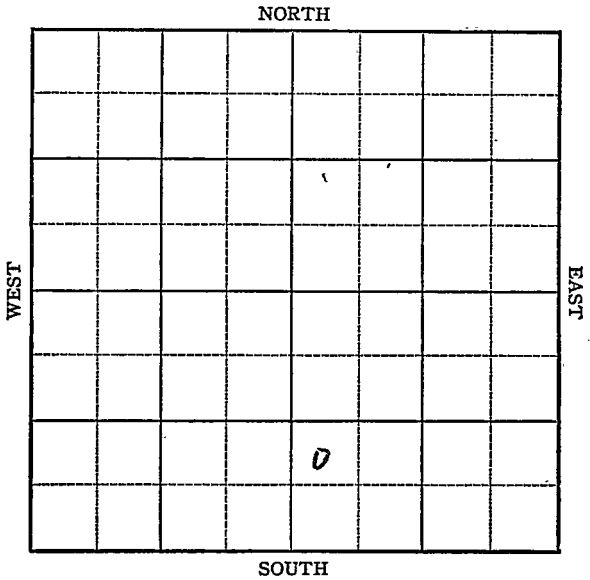

Sec. 7 Twp. 31 R. 14W

Well No. #3 Oldfather Farm
Sinclair-Prairie Company


Skinner

_____ Ft. from N. Line

990 Ft. from S. Line

_____ Ft. from E. Line

330 Ft. from W. Line

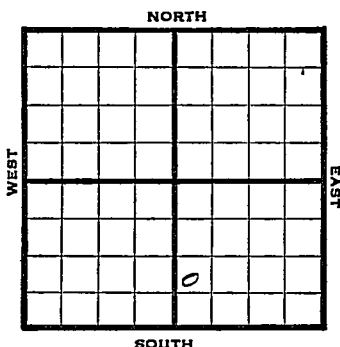

NW SW SE

1946 **Elev. 1645'** **REPORT**

- 10/16 Location
- 10/22 RUR
- 10/29 15" @ 148
Drlg 2200'
- 11/6 10" @ 708'
Drlg 3975'
- 11/12 Douglas 3650
Lans 3753'
Drlg 4360'
- 11/20 Viola 4321'
Simp sd 4439
Arb 4535-85 TD
- 11/27 5" @ 4585'
41 shots 4436-4442'
Flow 50 oil PH 2 hrs
- 12/3 Flow 343 oil in 5 hrs
- 12/11 Simp 4439'
Arb 4555'
5" @ 4585'
TD 4585'
Perf Simp.
Depth Pot 2650'
32 Grav.

COMPLETED

