

KANSAS

FORM 51 5M BRIX

Barber County

Section 7 Township 31 Range 14W

Well No. #1 Glenn Oldfather


Company Sinclair-Prairie

O.W.D.D

NORTH

WEST

EAST

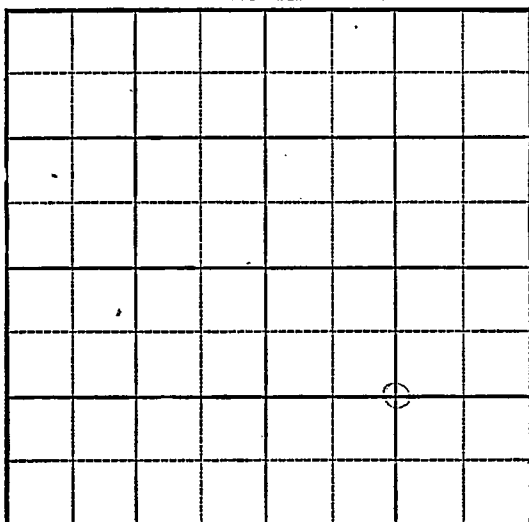

SOUTH

Sec. 7 Twp. 31 R. 14W

Well No. #1 Glenn Oldfather Farm

Sinclair-Prairie Company

Wildcat

NORTH


 Ft. from N. Line

1320 Ft. from S. Line

1320 Ft. from E. Line

 Ft. from W. Line

6 Rev. 1640

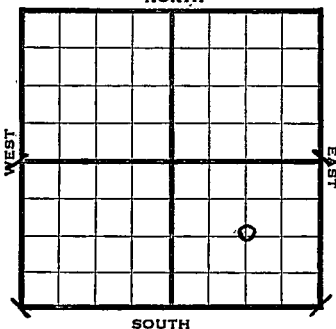

1944

REPORT

7/12	Loc.	
7/19	"	
7/26	"	
8/2	"	
8/9	"	
8/16	"	
8/23	"	
8/30	"	
9/8	"	
9/13	Drk.	
9/21	"	
9/28	"	
10/4	16" @ 37'	600 fsg.
10/11	1050 fsg.	
10/18	10" @ 561	WOC
10/25	8" @ 720	Drlg. 1550
11/1	TDrlg. 2605	
11/8	Drlg. 3745	5" @ 4554 RUST
11/16	Viola	4334
	Drlg.	4372
11/24	Simp 4429	Arb 4554 TD 4561 SD
	5" @ 4554	RUST
11/29	" " " " " " " "	
12/6	" " " " " " " "	
12/14	" " " " " " " "	

OVER

1944

12/21 TD 4561'
1900' oil in 7 hrs. 4000' oil
Gravity 27.

12/29 PB 4559'

1945

1/10 Arb 4554
5" @ 4554
PB 4559
TD 4561
500 acid
Pump 221 oil plus 72 wtr Pot
Grav. 27.0

COMPLETED
O.W.D.D

1946

3/7 Old well completed 1-10-45
Pumped 221 bbls. oil & 72 bbls.
water.
Stopped production & plugged back
to Simpson sand 4418'
Set plug @ 4500'
Perforated 6 shots 4420'-25'
Rec. 950' oil in $\frac{1}{2}$ hour.
Perforated 12 shots 4422'-26'
Flowed 45 bbls. oil in $\frac{1}{2}$ hour
Tanks full
Waiting on empty tanks. (Tel)

3/14 " " "
3/21 " " " " " " " " " " " "

3/27 Arb. 4545
Simp Sd. 4418
5" @ 4556
Perf. Simp.
TD 4556
Bomb Pot. 6909
Grav. 36.0

COMPLETED

KANSAS

Pool Name WildcatMap No. 93 Sec. 7 Twp. 31 R. 14WWell No. 1 Glenn OldfatherSinclair-Prairie


Company

FIRST REPORT

Contractor

C SE

SECTION PLAT

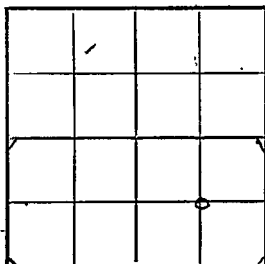

Ft. from N. Line

1320 Ft. from S. Line1320 Ft. from E. Line

Ft. from W. Line

Barber County

RECORD

Location XCased in., ft.Sand Gas Oil Total Depth Rig up

Drilling and Remarks:

PRODUCTION

1st 24 hrs. Nat. 1st 24 hrs. after shot Gas Cu. Ft.Dry Hole Abandoned

Date

JUL 12 1944 19 S. J. LEWIS Scout

Misc. Small Maps *Oma*
Cards *Oma*
Tracing *Me*
France Map *[initials]*
Scarborough Map *[initials]*
Moody Map *[initials]*
Geological Dept.
Moody Plat Book

Pool Name SkinnerMap No. 93 Sec. 7 Twp. 31 R. 14WWell No. 1 Glenn OldfatherSinclair-Prairie


Company

COMPLETED

Contractor

C SE

SECTION PLAT

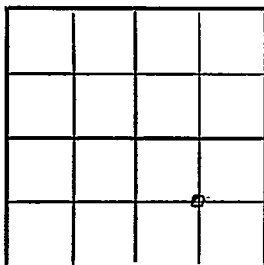

_____ Ft. from N. Line

1320 Ft. from S. Line1320 Ft. from E. Line

_____ Ft. from W. Line

Barber

Location _____

Rig up _____

Drilling and Remarks:


RECORD

Cased _____ in., _____ ft.

Sand _____

Gas _____

Oil _____

Total Depth 4561

PRODUCTION

1st 24 hrs. Nat. _____

1st 24 hrs. after shot _____

Gas _____ Cu. Ft.

Dry Hole _____

Abandoned _____

Date

JAN 10 1945

19

S. J. LEWIS

Scout

Misc. Small Maps	DR
Cards	DR
Tracing	DR
France Map	DR
Scarborough Map	DR
Pierce Map	DR
Geological Dept.	
Pierce First Book	

KANSAS Kansas Pool Name SkinnerMap No. 23 Sec. 7 Twp. 31 R. 14WWell No. 1 OldfatherSinclair-Prairie


Company

FIRST REPORT

Contractor

C SE

SECTION PLAT

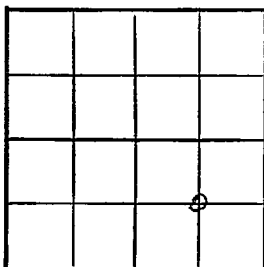 Ft. from N. Line1320 Ft. from S. Line1320 Ft. from E. Line Ft. from W. LineBarber CountyOilLocation Rig up

Drilling and Remarks:

simp Sh 4416

Simp Sd 4418

Arb. 4545

5"-4556

plug 4500

6 shots 4420-25

950' oil $\frac{1}{2}$ hr.

12 shots 4422-26

flow 45 oil $\frac{1}{2}$ hr.

RECORD

Cased in., ft.Sand Gas Oil Total Depth 4556

PRODUCTION

1st 24 hrs. Nat. 1st 24 hrs. after shot Gas Cu. Ft.Dry Hole Abandoned


Date

MAR 6 1946

19

S. I. LEWIS

Scout

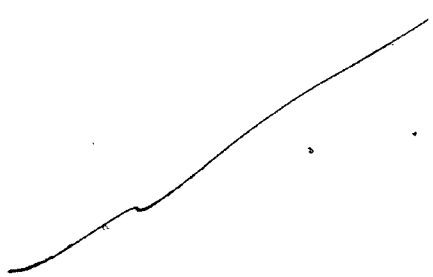

Handwritten signature or initials.

Misc. Small Maps _____

Cards _____

Tracing _____

France Map _____

Scarborough Map _____

Pierce Map _____

Geological Dept. _____

Pierce Plat Book _____

Kansas Pool Name Skinner

KANSAS
 Map No. 43 Sec. 7 Twp. 31 R. 14W
 Well No. 1 Oldfather


Sinclair-Prairie

Company

COMPLETED

Contractor

C SE

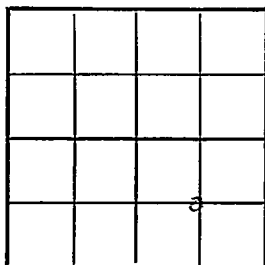E11640
 SECTION PLAT
 Ft. from N. Line1320 Ft. from S. Line1320 Ft. from E. Line Ft. from W. LineBarber CountyLocation Rig up

Drilling and Remarks:

Cor 4545
Snip 4418
5104556
Per Snip
Born 4546908
Q60-4

RECORD

Cased in., ft.Sand Gas Oil Total Depth 4556

PRODUCTION

1st 24 hrs. Nat. 1st 24 hrs. after shot Gas Cu. Ft.Dry Hole Abandoned

Date

MAR 27 1946 19

S. J. LEWIS

Scout

Misc. Small Maps ✓
Cards Dorothy
Tracing 7
France Map 7
Scarborough Map ✓
Pierce Map ✓
Geological Dept. ✓
Pierce Plat Book ✓