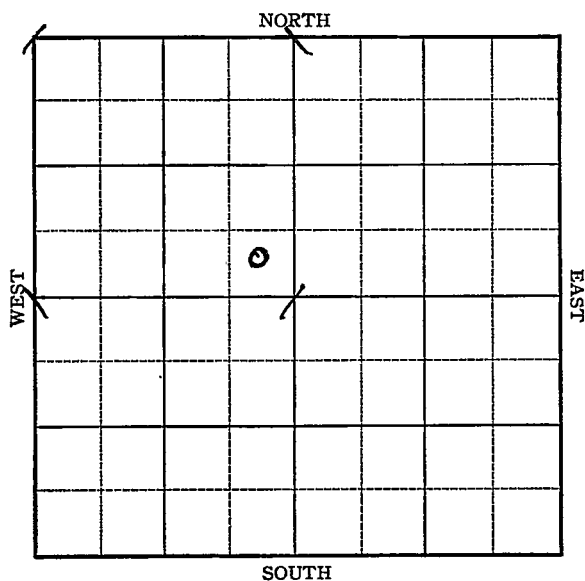



Barber

KANSAS

Section 7 Township 31 Range 13-WWell No. 1 Gant "B"Company Pryor & Lockhart

Sec. 7 Twp. 31 R. 13 -WWell No. #1 Gant "B" FarmPryor & Lockhart Company Ft. from N. Line440 Ft. from S. Line440 Ft. from E. Line Ft. from W. Line

Elev. 1696'.

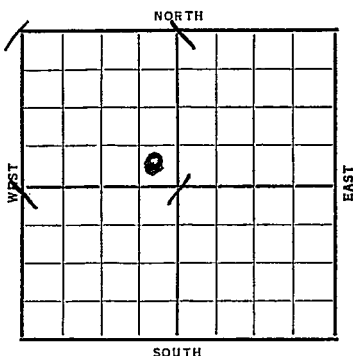

Date

REPORT

1937

12/8

Location

12/17

"

12/24

"

12/31

"

1938

1/7

"

1/14

Cellar.

1/20

15"-360' T.D. 600 WOC.

1/28

Drlg. 1835'

2/4

Drlg. 2892'.

2/11

Anhy 615'. Florence Flint 2180'

Tarkio 2908'. Drlg. 3768'.

2/18

Lans. 3820'. Drlg. 4100'.

2/26

Chat. 4335'. Base line 4385'.

Drlg. 4410'.


OVER

1938

3/3--Misener 4434 Viola 4435
Simpson shale 4552 Simpson sand 4564
Arbuckle 4642 T.D. 4665
Porous lime No show oil (Tel)

3/2 Misner 4434'.
Viola 4435'.
Simpson shale 4552'.
Simpson sand 4564'.
Arbuckle 4642'.
T.D. 4665'.
Porous lime, but no oil.

ABANDONED

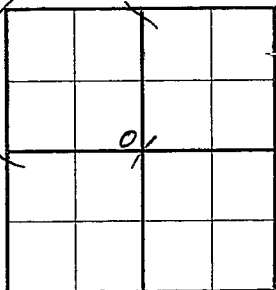Map No. 93 Sec. 7 Twp. 31 R. 13WWell No. 1 Gant "B"Pryor & Lockhart Company Contractor**FIRST REPORT****SE NW** Ft. from N. Line440 Ft. from S. Line440 Ft. from E. Line Ft. from W. Line**SECTION PLAT**Location XRig up

Drilling and Remarks:

RECORDCased in., ft.Sand Gas Oil Total Depth **PRODUCTION**1st 24 hrs. Nat. 1st 24 hrs. after shot Gas Cu. Ft.Dry Hole Abandoned

Date

DEC 8 - 1937 19 H. D. Hatfield Scout

1. 2. 84

RAY


Paul

[Handwritten signature]

Barber KANSAS

Map No. 93 Sec. 7 Twp. 31 R. 13WWell No. 1 Gant "B"Pryor & Lockhart Company

Contractor

ABANDONED

SE NW

 Ft. from N. Line440 Ft. from S. Line440 Ft. from E. Line Ft. from W. Line

SECTION PLAT

| | | | |
|--|--|--|--|
| | | | |
| | | | |
| | | | |
| | | | |
| | | | |

Location Rig up

Drilling and Remarks:

Misner 4434
 Viola 4435
 Simp. Sh. 4552
 Simp sand 4564
 Arb. 4642
 TD 4665
 Porous Lime but no oil
 DVA

RECORD

Cased in., ft.Sand Gas Oil Total Depth

PRODUCTION

1st 24 hrs. Nat. 1st 24 hrs. after shot Gas Cu. Ft.Dry Hole Abandoned

Date

MAR 2 - 1938 19

H. D. Hatfield Scout

RAY

| | |
|-----------------------|------|
| Returned | |
| Cards | Paul |
| Tracing | Ray |
| France Map | Ray |
| Scarborough Map | Ray |
| Moody Map | |
| Scarborough Plat Book | |
| Moody Plat Book | |