


Section 7 Township 31N Range 36W

Well No. #1 Fox Unit

Company Magnolia

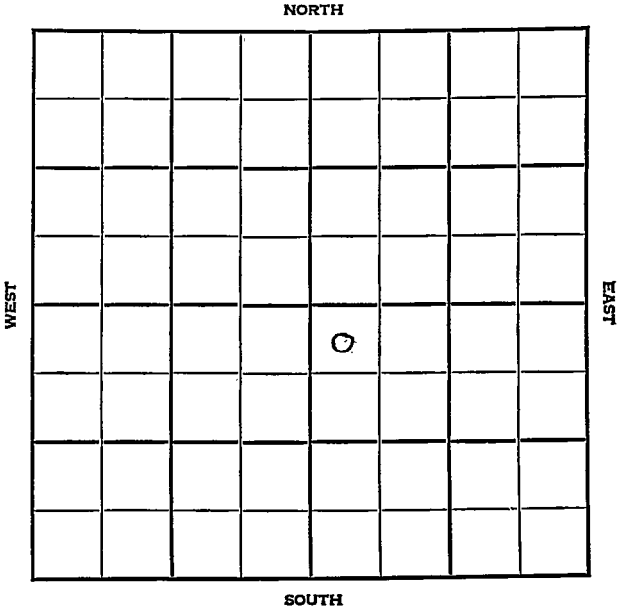

Sec. 7 Twp. 31 R. 36W

Well No. #1 Fox Unit Farm _____
Magnolia Company _____
Hugoton Pool


330' Ft. from N. Line

_____ Ft. from S. Line

_____ Ft. from E. Line

330' Ft. from W. Line

NW SE

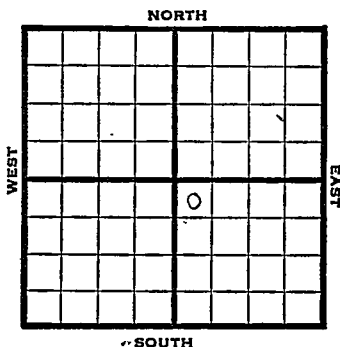

1948

Eli 3056'

R E P O R T

- 6/9 Location
- 6/16 10" @ 657'
WOC
- 6/23 TD 2810'
7" @ 2809'
- 6/29 TD 2810 -
- 7/8 120 shts 2714-51 7000 acid
168 shots 2668-2702 7000 acid
72 shots 2612-30 7000 acid
144 shots 2559-88 7000 acid
- 8/14 " "
- 7/21 TD 2810'
7" @ 2809'
Perf 28000 acid
18,600,000 Gas
390 # R Pr.
Comp .

COMPLETED

Map No. _____ Sec. 7 Twp. 31 R. 36W

Well No. 1 Fox Unit

Magnolia Company

FIRST REPORT Contractor

NW SE

SECTION PLAT

330 Ft. from N. Line

_____ Ft. from S. Line

_____ Ft. from E. Line

330 Ft. from W. Line

		o	

Stevens County

Location _____

Rig up _____

Drilling and Remarks:

RECORD

Cased _____ in., _____ ft.

Sand _____

Gas _____

Oil _____

Total Depth _____

PRODUCTION

1st 24 hrs. Nat. _____

1st 24 hrs. after shot _____

Gas _____ Cu. Ft.

Dry Hole _____

Abandoned _____

Date

JUN 9 1948 19

S. J. LEWIS Scout

Map No. _____ Sec. 7 Twp. 31 R. 36W

Well No. 1 Fox Unit

Magnolia Company

COMPLETE

Contractor

NW SE

E. 13056

SECTION PLAT

330 Ft. from N. Line

_____ Ft. from S. Line

_____ Ft. from E. Line

330 Ft. from W. Line

		6	

Stevens County

RECORD

Location _____

Cased _____ in., _____ ft.

Rig up _____

Sand _____

Drilling and Remarks:

Gas _____

7" casing

Oil _____

Perf.

Total Depth 2870

25000 acid

18,600,000 Gas

PRODUCTION

1st 24 hrs. Nat. _____

1st 24 hrs. after shot _____

Gas _____ Cu. Ft.

Dry Hole _____

Abandoned _____

890 R R*

Date

JUL 21 1948

19

S. J. LEWIS

Scout