

KANSAS

Seward


Section 7 Township 31 Range 33W

Well No. 1 Gunn

Company Cities Service

Hugoton

NORTH

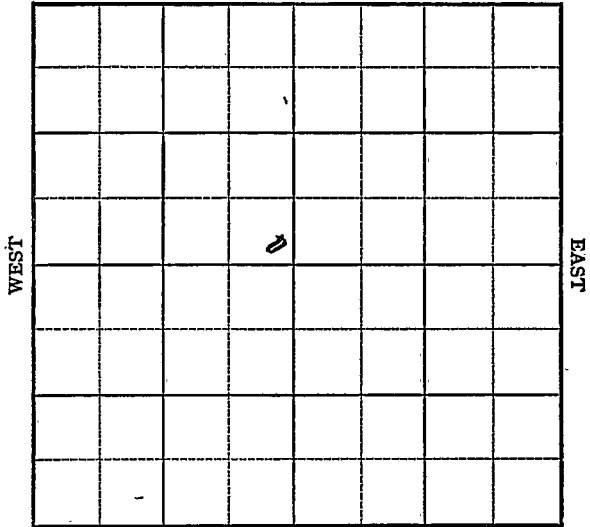


SOUTH

Sec. 7 Twp. 31 R. 33W

Well No. #1 Gunn Farm _____

Cities Service Company
Hugoton Pool (Lohman & Johnson, Cont.)

_____ Ft. from N. Line
100'
_____ Ft. from S. Line
100'
_____ Ft. from E. Line
_____ Ft. from W. Line
SE NW

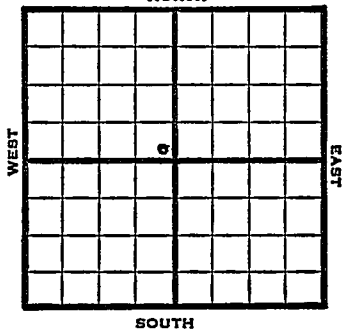

1949

Elev 2928' REPORT

8/10 8" @ 560'
8/17 TD 2770'
5" @ 2769'
8/24 "
8/31 375' shots 2624-2744
5000 acid
9/7 Total of 29000 acid
9/14 TD 2770'
5" @ 2769'
Perf 29000 acid
28,500,000 Gas
435# R. Pr.
Comp

COMPLETED

Map No. _____ Sec. 7 Twp. 31 R. 33W

Well No. 1 Gunn

Cities Service Company

Lohman & Johnson Contractor

SE NW

**FIRST REPORT
SECTION PLAT**

_____ Ft. from N. Line

100 Ft. from S. Line

100 Ft. from E. Line

_____ Ft. from W. Line

		o	

Seward County

RECORD

Location _____

Cased _____ in., _____ ft.

Rig up _____

Sand _____

Drilling and Remarks:

Gas _____

Oil _____

8" @ 560

Total Depth _____

PRODUCTION

1st 24-hrs. Nat. _____

1st 24 hrs. after shot _____

Gas _____ Cu. Ft.

Dry Hole _____

Abandoned _____

Date

AUG 10 1949

19

S. J. LEWIS

Scout

Map No. Sec. 7 Twp. 31 R. 33W

Well No. 1 Gunn

Cities Service Company

COMPLETE Contractor

SE NW

E12925

- SECTION PLAT

 Ft. from N. Line

100 Ft. from S. Line

100 Ft. from E. Line

 Ft. from W. Line

Seward County

Location

Rig up

Drilling and Remarks:

5" @ 2769

Perf.

29000 acid

28,500,000 Gas

485 RA

RECORD

Cased in., ft.

Sand

Gas

Oil

Total Depth 2770

PRODUCTION

1st 24 hrs. Nat.

1st 24 hrs. after shot

Gas Cu. Ft.

Dry Hole

Abandoned

Date

SEP 14 1949 19

S. J. LEWIS Scout