

Sumner

KANSAS

7

31S

1W

SECTION \_\_\_\_\_ TOWNSHIP \_\_\_\_\_ RANGE \_\_\_\_\_


#1 E.J. Shaffer

WELL NO. \_\_\_\_\_

Skelly Oil Co.

COMPANY \_\_\_\_\_

NORTH N/2 NW NW

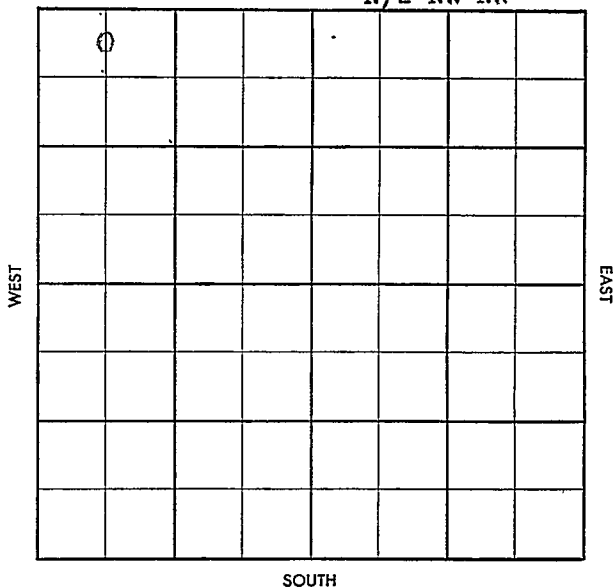

~~Top~~ Pool ~~31~~  
~~Common~~ ~~1st~~ ~~25~~

S-513-B

County Sumner Elev. \_\_\_\_\_  
 Sec. 7 Twp. 31 Rge. IW  
 Company Skelly Oil Co  
 Farm Name E. J. Shaffer No. 1

TOPS	DEPTH	LOG	DATUM
Anh.			
Tp.			
H.			
Tr.			
Dg.			
B.L.			
L.			
K.C.			
B.K.C.			
Ce.			
C.			
M.			
M.			
K.			
Mz.			
Mq.			
V.			
S.			
S.			
A.			
R.			
Pf.			
G.			
T.D.			

Loc. in Sec. \_\_\_\_\_  
N/2 NW NW  
660' fwl x  
380' fnl  
 Geol. \_\_\_\_\_  
 Contr. \_\_\_\_\_  
 Pool Anson-SE  
100' S of C of  
Mo. Pac. R.O.W.

AUG 13 1939  
 FIRST REFOUR

Date Comm. \_\_\_\_\_  
WORT  
 \_\_\_\_\_  
 \_\_\_\_\_  
 \_\_\_\_\_  
 \_\_\_\_\_  
 \_\_\_\_\_  
 \_\_\_\_\_

Co. \_\_\_\_\_  
 Use. \_\_\_\_\_  
 No. \_\_\_\_\_  
 Sec. \_\_\_\_\_  
 T. \_\_\_\_\_  
 R. \_\_\_\_\_

Twp. Pool  
 Co. Facet

S-513-B

County Sumner Elev. 12870 12870  
 Sec. 7 Twp. 31 Rge. 1284 1W  
 Company Skelly Oil Co  
 Farm Name E. J. Shaffer No. 1

TOPS	DEPTH	LOG	DATUM
Anth.			
Tp.			
H.			
Tr.			
Dg.			
B.L.			
L.			
K.C.	3250		
B.K.C.	3303		
<del>E. C.</del>	3374		
<del>E. C.</del>	3573		
M. <u>Li</u>	3701		
M.			
K.			
Mz.			
Mq.			
V.			
S.			
S.			
A.			
R.			
Pf.			
G.			
T.D.	3790		

Loc. in Sec. N/2 NW 1W  
660' fwl x  
300' fnl  
 Geol. \_\_\_\_\_  
 Contr. \_\_\_\_\_  
 Pool Anson-SE  
100' S of C of  
No. sec. 7. C. N.

0  
**ABANDONED**  
 SEP 17 '58

Date Comm. 9-2-58 4' 490/1250  
 WPT AUG 20 '58 AUG 27 '58 SEP 3 '58 SEP 10 '58

Ø 2885 SEP 17 '58 Ø ST 3720-50 60"  
9.4' DM BHP 980/100" Ø ST (SD)  
3695 - 3725' 142. 37' DM BHP  
5 1/20" log

D6A