


DX 78-1 Summer

KANSAS

Section 7 Township 31 Range 3W

Well No. #2 Grabendike

Company Anchor Petroleum

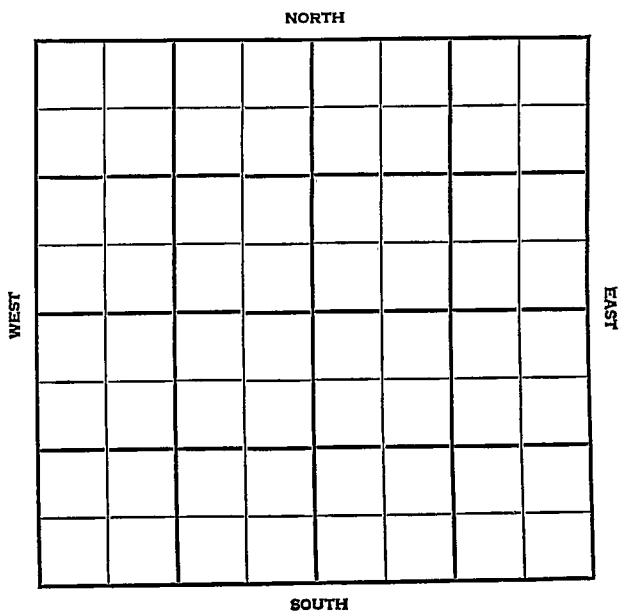

Summer		KANSAS	
SEC.	TWP.	R.	
7	31	3W	

WELL NO.

#2 Grabendike

FARM

COMPANY

Anchor Petroleum

CONTRACTOR

McKnab & Lindsey

Kerschen


_____ FT. FROM N. LINE

_____ FT. FROM S. LINE

_____ FT. FROM E. LINE

_____ FT. FROM W. LINE

SE SW SE

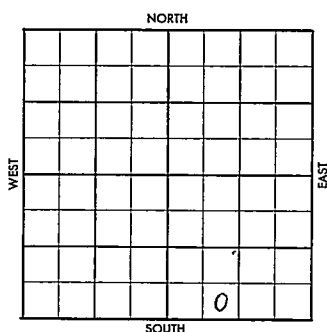

	ELEVATION	REPORT
1956	1396'	
6-6	Comm. 6-3-56	
	8" @ 300 w/250	
6-20	Coring 3437'	
	crd 3437-73 Full rec.	
	DST 2818-52, op 45 min, rec 120' msw	
	BHP 1035/ 20"	
	DST 3461-73, open 2 hrs, rec 180' gip	
	rec 60' ogcm / 360' sw	
	BHP 1130/ 30"	
	D & A	
	Ely 2618', H. 2319', B.L. 3051',	
	Stall 3126', 3324' K. C. 3334',	
	TD 3473'	
	ABANDONED	

County Sumner Elev. _____
Sec. 7 Twp. 31 Rgs. 3W
Company Anchor Petroleum
Farm Name Grabendike No. 2

TOPS	DEPTH	LOG	DATUM
Anh.			
Tr.			
H.			
Tr.			
Dg.			
BL.			
L.			
K.C.			
B.K.C.			
Ce.			
C.			
M.			
M.			
K.			
Mz.			
Mo.			
V.			
S.			
S.			
A.			
R.			
Pe.			
G.			
T.D.			

Loc. in Sec. SE SW SE
Geol. _____
Contr. _____
McKrab &
Pool Lindsey
Kerschen

JUN 6 1956
HARRY REPORT

Date Comm. 6-3-56
8" @ 300/250

[Handwritten signature]
2221 1 1 1111
D.H.

County Sumner Elev. 1237
 Sec. 7 Twp. 31 Rge. 3W
 Company Anchor Petroleum
 Farm Name Grabendike No. 2

TOPS	DEPTH	LOG	DATUM	Loc. in Sec.
Anh.				
TP. <u>El.</u>	<u>2618</u>			<u>SE SW SE</u>
H. <u>1</u>	<u>2819</u>			
Tr.				
Dg.				
BL.	<u>3051</u>			
L. <u>stall</u>	<u>3126</u>			
K.C.	<u>3334</u>			Geol.
BKC.				Contr.
Ce.				<u>McKnab &</u>
C.				<u>Lindsey</u>
M.				Pool
M.				<u>Kerschen</u>
K.				
Mz.				
Mo.				
V.				
S.				
S.				
A.				
R.				
PE.				
G.				
T.D.	<u>3473</u>			

ABANDONED

Date Comm. 6-3-56

JUN 20 1956

8" @ 300/250 JUN 13 '56 3437- ? JUN 20 '56cnd ~~3437-52~~ 3437-73 Full

Rec. DST 2818-52 45" rec.

120' MSW 1035/20" DST 3461

-73 2 hrs rec 180' G1P rec

60' OACM + 360' SW BHP 1138/30

D & A