
DX 78-1

Harper KANSAS

Section 7 Township 31 Range 8W

Well No. 1 Kernchan (Kernohan)

Company Republic Natural

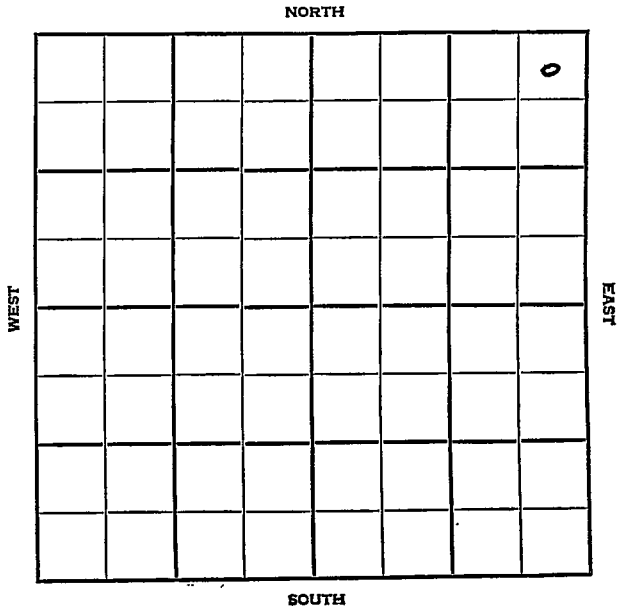

Harper KANSAS

SEC.	TWP.	R.
7 -	31	8W

WELL NO.

1 Kernohan FARM

COMPANY

Republic Natural

CONTRACTOR

Beardmore Drlg.


Grabs Pool

330 Ft. from N. Line

Ft. from S. Line

330 Ft. from E. Line

Ft. from W. Line

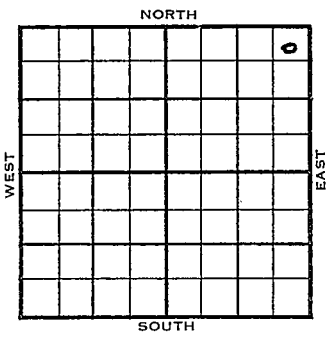

NE NE NE

1954 ELEVATION 1681' REPORT

6/15 M I R
6/23 8" @ 160
6/30 Drlg. 4180
7/7 Miss 4387
RTD 4530
Schl Tops Lans 3644 Miss 4386
5" @ 4258

8/25 Spud 6-20-54 Oil well TD 4530
8" @ 160 Miss 4386 TD 4530
Lans. 3644 5" @ 4528 CO to 4486
150/4440-65 sd-frac. S/3½ BOPH
P/14 BO 50% wtr. P/14 BO 14 BWPD
P/25 BO 20 BW
Comp. 9 BOPD 40% wtr.

COMPLETED

DX-78

FORM 275 FOR SALE BY KANSAS BLUE PRINT CO.


County Harper State Kansas

Sec. 7 (Blk. Twp.) 31 (Sur. Rge.) 8W Map No.

Operator Republic Natural

Well No. 1 Farm Kernohan

Elev. Location NE NE NE

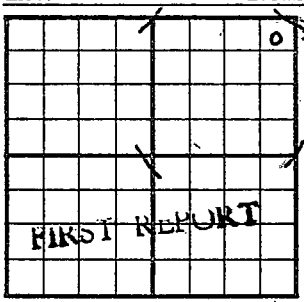

330 Ft. From N Line NE

330 Ft. From E Line Quarter

1st. Report JUN 15 1954

Completion

Remarks Beardmore Drlg. - Contr

Spudding Date

Drlg. Data Grabs Pool

MIR

J. G. McGEHEE

FORM 275 FOR SALE BY KANSAS BLUE PRINT CO.


County Harper State Kansas

Sec. 7 (Blk. Twp.) 31 (Sur. Rge.) 8W Map No.

Operator Republic Natural

Well No. 1 Farm Kernohan

Elev. 1681 Location NE NE NE

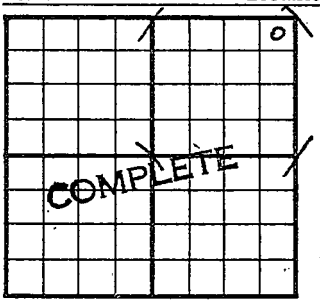

330 Ft. From N Line NE

330 Ft. From E Line Quarter

1st. Report

Completion AUG 25 1954

Remarks Grabs Pool

Beardmore Drlg. - Contr.

Spudding Date 6-20-54

Drlg. Data Oil well TD 4530

8" @ 160 Miss. 4386 TD 4530 Lans. 3644

5" @ 4528 CO to 4486 150/ 4440-65

sd-frac S/ 3½ boph P/ 14 bo 50% wtr.

P/ 14 bo 14 bwpd P/ 25 bo 20 bw

Comp. 9 bopd 40% wtr.

FABEN GILSTRAP