


Section 7 Township 31 Range 8-W

Well No. #1 Wingate

Company Drillers Gas etal

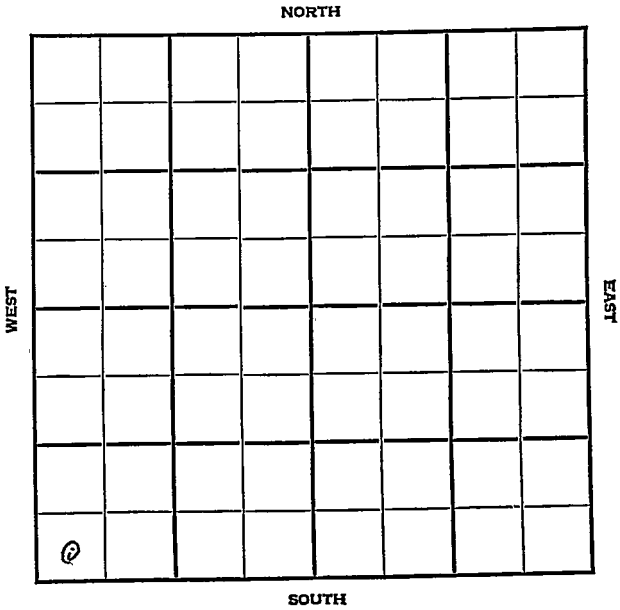

KANSAS

Harper

Sec. 7 Twp. 31 R. 8W

Well No. #1 Wingate Farm

Drillers Gas et al Company

Wildcat


Ft. from N. Line

330' Ft. from S. Line

Ft. from E. Line

330' Ft. from W. Line

SW/C

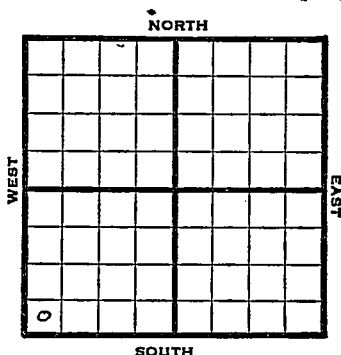

1948

Eli 1648'

REPORT

7/21

Location

7/28

10" @ 253'
Drlg 1680'

8/4

Drlg. 3330'

8/11

Topeka 2940'
Lansing 3635'
Drlg 4077'

8/18

Mississippi 4385'
DST 4382-4403 opn 1 hr
1 M Gas 30' wanac 30' oil mud 4403-4510
DST 4407-4515 opn $\frac{1}{2}$ hr.
1200' oil & gas cut mud
B Mississippi 4567
Kinderhook 4690
Viola 4726
Simpson Sand 4782'
Drlg 4808'

8/25

Arbuckle 4905'
TD 4928'
5" @ 4812'

9/1

12 shots 4444-48
Swb 30 bbls oil & 30 W - 24 hrs.

9/8

"

9/14

1000 acid
Swb 60 bbls fluid 85% W

OVER

4782
1648
3134

1948

9/21 1000 acid

Swb 60 bbls fluid 95% W

9/29 TD 4928'

Arb. 4905'

Aband.

ABANDONED

Map No. _____ Sec. 7 Twp. 31 R. 8W

Well No. 1 Wingate

Drillers Gas etal. Company

FIRST REPORT

Contractor

SW/C

SECTION PLAT

_____ Ft. from N. Line

330 Ft. from S. Line

_____ Ft. from E. Line

330 Ft. from W. Line

Harper County

Location X

Rig up _____

Drilling and Remarks:

RECORD

Cased _____ in., _____ ft.

Sand _____

Gas _____

Oil _____

Total Depth _____

PRODUCTION

1st 24 hrs. Nat. _____

1st 24 hrs. after shot _____

Gas _____ Cu. Ft.

Dry Hole _____

Abandoned _____

Date

JUL 21 1948

19

S. J. LEWIS

Scout

19 300 Pl. 1. 1. 1.

100


103 14

ACKNOWLEDGMENTS

FILE 023

9 2 7 10)

440 10 25

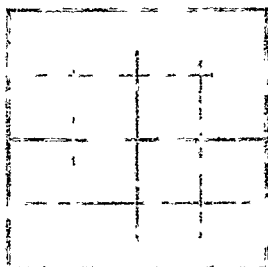









Misc. Small Maps
Cards
Tracing
France Map
Scarborough Map
Pierce Map
Geological Dept.
Pierce Plat Book

93156

1999





Map No. 33 Sec. 7 Twp. 31 R. 8WWell No. 1 Wingate

Drillers Gas etal. _____ Company

ABANDONED

Contractor


SW/C

E. 1648
SECTION PLAT

_____ Ft. from N. Line

330 Ft. from S. Line

_____ Ft. from E. Line

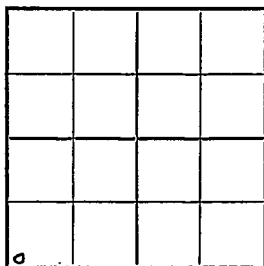330 Ft. from W. Line

Harper County

Location _____

Rig up _____

Drilling and Remarks:

CE 4905

RECORD

Cased _____ in., _____ ft.

Sand _____

Gas _____

Oil _____

Total Depth 4928

PRODUCTION

1st 24 hrs. Nat. _____

1st 24 hrs. after shot _____

Gas _____ Cu. Ft.


Dry Hole _____

Abandoned _____

Date

SEP 29 1948 19S. J. LEWIS Scout

REMOVED

 

Misc. Small items	<i>[Signature]</i>
Cards	<i>[Signature]</i>
Tracing	<i>[Signature]</i>
France Map	<i>[Signature]</i>
Scarborough Map	<i>[Signature]</i>
Pierce Map	<i>[Signature]</i>
Geological Dept.	
Pierce Plat Book	