
FORM 51 Harper

KANSAS

Section 7 Township 31 Range 8W

Well No. 3 Wingate

Company ~~Beardmore Drlg.~~ DRILLERS GAS

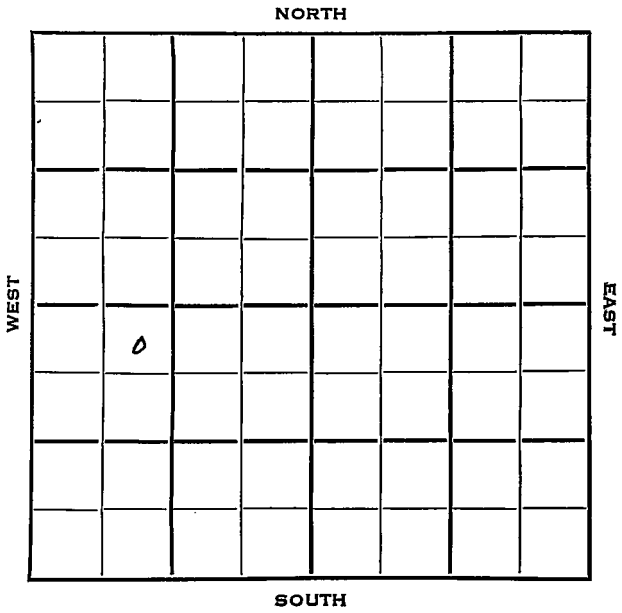

FORM 252-B

Harper KANSAS ✓

Sec. 7 Twp. 31 R. 8W

Well No. #3 Wingate Farm

~~Beardmore Drlg.~~ Drillers Gas Company

Beardmore Drlg. Contractor


330 Ft. from N. Line

Ft. from S. Line

Ft. from E. Line

990 Ft. from W. Line

NE NW SW

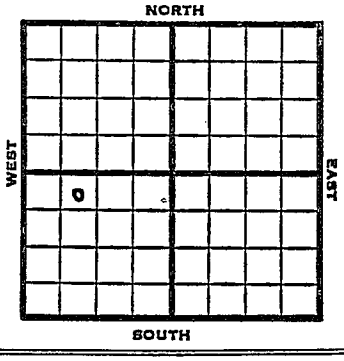

1953	Elev. 1640' REPORT
2/4	RUR
2/12	8" @ 189 Drlg. 2975
2/19	Miss 4385 DST 4386-4401, 1 hr., 70' GCM, 1500# 15" Drlg. 4414'
2/26	DST 4416-25 1 Hr. 20' M V 4712-25 RTD 5" @ 4475
3/12	NR
3/19	NR
3/26	NR
4/2	"
4/9	NR
4/16	"
4/23	"
4/30	"
5/7	NR
5/21	CO 4418 60/ 4386-4402 est 250,000 gas / 10 goph Hyd.
5/28	NR

OVER

1953
6/24 Spud 2-4-53
Gas & Oil Well
TD 4725
8" @ 189
Miss 4385
DST 4386-4401, opn 1 hr., rec. 70' gcm, 1500#
DST 4416-25, opn 1 hr., rec. 20' mud,
Viola 4712-25,
5" @ 4475, CO to 4418
60/4386-4402, 250,000 gas, 10 goph Hydro
Comp. 340,000 gas, 12 go 3 bwpd

COMPLETED

FORM 275 FOR SALE BY KANSAS BLUE PRINT CO.

County Harper State Kansas

Sec. 7 (Blk. Twp.) 31 (Sur. Rge.) 8W Map No.

Operator Beardmore Drlg.

Well No. 3 Farm Wingate

Elev. Location NE NW SW

FIRST REPORT

330 Ft. From N Line SW

990 Ft. From W Line Quarter

1st. Report FEB 4 1953

Completion

Remarks Beardmore Drlg. - Contr.

Spudding Date

Drlg. Data

R T R

J. G. McGEHEE

Scout Cards
Land Small Map
Land Wall Map
Tracings
France Map
Pierce Map
Misc.

FEB 6 1953

Drlg. Data

Form 26—200 Bks.—1-48—Palace

Kansas

Map No. _____ Sec. 7 Twp. 31 R. 8W


Well No. 3 Wingate

Drillers Gas Company

CORRECTION Contractor

NE NW SW

SECTION PLAT

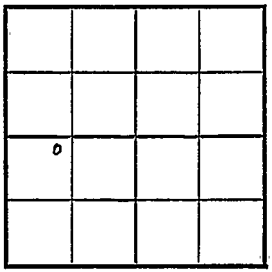

330 Ft. from N. Line

_____ Ft. from S. Line

_____ Ft. from E. Line

990 Ft. from W. Line

Harper County

Location _____

Rig up _____

Drilling and Remarks:

Reported
Beardmore Drlg.

RECORD

Cased _____ in., _____ ft.

Sand _____

Gas _____

Oil _____

Total Depth _____

PRODUCTION

1st 24 hrs. Nat. _____

1st 24 hrs. after shot _____


Gas _____ Cu. Ft.

Dry Hole _____

Abandoned _____

Date

MAR 4 1953 19____ J. G. McGEHEE Scout

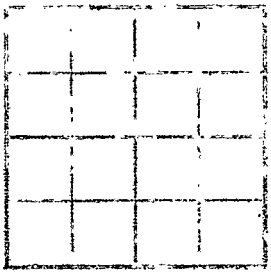

MAR 6 1953

Scout Cards
Land Small Maps
Land Wall Map
Tracings
France Map
Prints Map
Misc.

FORM 275 FOR SALE BY KANSAS BLUE PRINT CO.


County Harper State Kansas

Sec. 7 (Blk. Twp.) 31 (Sur. Rge.) 8W Map No.

Operator Drillers Gas Co.

Well No. 3 Farm Wingate

Elev. 1640 Location NE NW SW

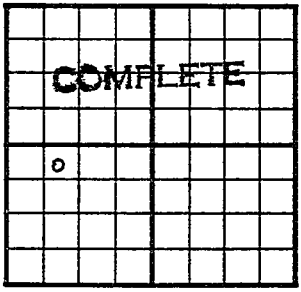

330 Ft. From N Line SW

990 Ft. From W Line Quarter

1st. Report

Completion JUN 24 1953

Remarks

Beardmore Drlg. - Contr.

Spudding Date 2-4-53

Drlg. Data Gas & oil well TD 4725

8" @ 189 Miss. 4385 DST 4386-4401

open 1 hr. Rec. 70' gcm 1500#

DST 4416-25 open 1 hr. Rec. 20' mud

Viola 4712-25 5" @ 4475 CO to 4418

60/ 4386-4402 250,000 gas 10 goph

Hydro. Comp. 340,000 gas 12 go 3 bwpd

J. G. McGEHEE

JUN 30 1953

Scout Cards	10
Land Small Map	
Land Wall Map	3
Tracings	
France Map	
Pierce Map	
Misc.	

Drlg. Data