

21-31-8W

WELL LOG BUREAU—KANSAS GEOLOGICAL SOCIETY
508 East Murdock, Wichita, Kansas


Company- STANOLIND OIL & GAS CO.
Farm- J. C. Burgess "B" No. 1

SEC. 21 T. 31 R. 8W
NW SW NW
1650' S of NL, 330' E of WL, NW/

County Harper
KANSAS

Total Depth. 4425
Comm. 6-4-55
Shot or Treated.
Contractor.
Issued. 9-10-55

PBTD 4403
Comp. 6-17-55

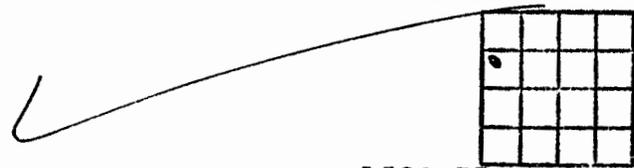

Elevation. 1593 RB

Production. 21 BO, 7 BWPD

CASING:
8 5/8 @ 214' w/ 250 sx cmt.
5 1/2 @ 4424' w/ 200 sx cmt.

Figures indicate Bottom of Formations.

clay & sand	85
red bed & shells	170
red bed	220
red rock & shale	710
shale	1107
lime & shale	1410
sandy lime	1455
lime & shale	2848
lime	2855
lime & shale	3035
lime	3570
lime & shale	3633
lime	3805
lime & shale	3975
lime & chert	3983
lime & shale	4240
broken lime	4285
lime & shale	4388
cherty lime, O & G 4403, SW@	4425
Total Depth	

Schlumberger TD 4422.5

TOPS:
Lansing 3633
Mississippi 4388

Ran Schlumberger Electric Logs to TD

Producing interval 4389-90