7-31-8W

WELL LOG BUREAU—KANSAS GEOLOGICAL SOCIETY
508 East Murdock, Wichita, Kansas

Company- PETROLEUM, INC.
Farm- Wingate No. 1

SEC. 7 T. 31 R. 8W
NW NW SE

Total Depth. 4500
Comm. 2-7-55 Comp. 2-23-55
Shot or Treated.
Contractor. Carl Todd Drlg Co.
Issued. 6-11-55

County Harper
KANSAS

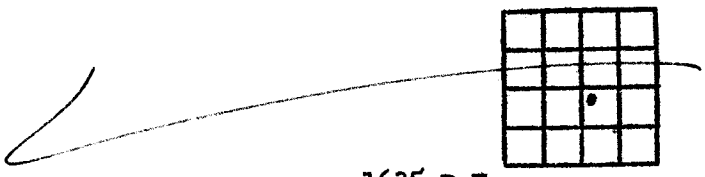

Elevation. 1635 D.F.

Production. 16 BO / 68% water

CASING:
8 5/8" 202' cem w/165 sx
4 1/2" 4496' cem w/ 65 sx

Figures indicate Bottom of Formations.

sand,w/shale strks	50
red bed, shells	202
shale,shells,red bed	1050
shale,shells	1480
anhydrite	1500
shale, lime	2085
shale	2490
shale, shells	2660
lime, shale	3645
lime	4310
lime,shale	4367
lime	4369
chert	4500
Total Depth RTD	

Tops: Scout	
Heebner	3419
Douglas	3553
Lansing	3615
Miss.	4369