


Section 8 Township 31 Range 14W

Well No. 4 Mills

Company Huber & C S O

Skinner Pool

NORTH

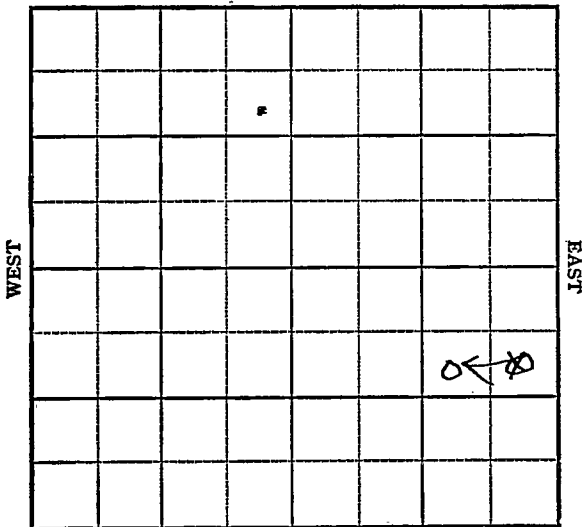

SOUTH

Sec. 8 Twp. 31 R. 14W ✓

Well No. 4 Mills Farm

Huber & C S O Company

Skinner Pool


990 Ft. from N. Line

\_\_\_\_\_ Ft. from S. Line

990'  
330' Ft. from E. Line

\_\_\_\_\_ Ft. from W. Line

SW NE SE  
SE NE SE

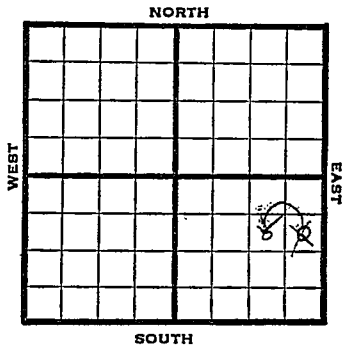

1948	Elv. 1632' REPORT
9/22	Location
9/29	16" @ 125' 10" @ 800'
10/6	Drlg. 3340'
10/13	"
10/19	Lansing 3760' Viola 4326' 5" @ 4349' TD 4361 1100 acid Flow 120 bbls oil 6 hrs.
10/26	Flow 10 bbls oil PH
11/3	Viola 4326' 5" @ 4349' 1100 acid Flow 204 oil Pot. Gr. 41° TD 4361'
<b>COMPLETED</b>	

Barber County Kansas State

Map No. \_\_\_\_\_ Sec. 8 Twp. 31 R. 14W

Well No. 4 Mills

Huber & C S O Company

FIRST REPORT Contractor

SE NE SE

SECTION PLAT

990 Ft. from N. Line

\_\_\_\_\_ Ft. from S. Line

330 Ft. from E. Line

\_\_\_\_\_ Ft. from W. Line

							6

Skinner Pool  
Remarks:

Location

Date  
SEP 22 1948

Scout S. J. LEWIS



Map No. 93 Sec. 8 Twp. 31 R. 14W

Well No. 4 Mills

Huber & C.S.O. Company

**COMPLETE**

Contractor

SW NE SE

*E11632*  
SECTION PLAT

990 Ft. from N. Line

\_\_\_\_\_ Ft. from S. Line

990 Ft. from E. Line

\_\_\_\_\_ Ft. from W. Line


Barber County

**RECORD**

Location \_\_\_\_\_

Cased \_\_\_\_\_ in., \_\_\_\_\_ ft.

Rig up \_\_\_\_\_

Sand \_\_\_\_\_

Drilling and Remarks:

Gas \_\_\_\_\_

Oil

Total Depth 4361

*No test 4326*  
*5' @ 4349*  
*1100 acid*  
*Flow 204 oil BT*

**PRODUCTION**

1st 24 hrs. Nat. \_\_\_\_\_

1st 24 hrs. after shot \_\_\_\_\_

Gas \_\_\_\_\_ Cu. Ft.

Dry Hole \_\_\_\_\_

Abandoned \_\_\_\_\_

*4128*

Date

NOV 3 1948 19

**S. J. LEWIS**

Scout