

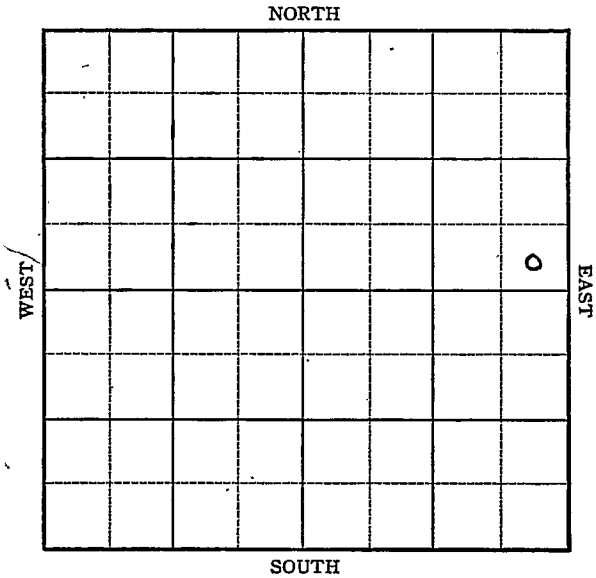
KANSAS

Barber

Section 8 Township 31 Range 14-W

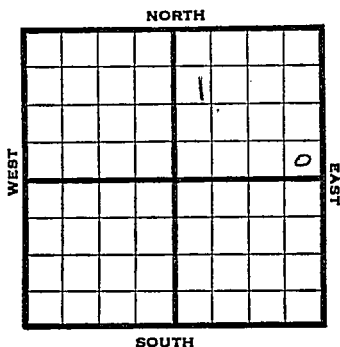
Well No. #1 D.W. Skinner

Company Huber & Anderson Prichard



KANSAS

Barber

Sec. 8 Twp. 31 R. 14-WWell No. #1 D. W. Skinner FarmHuber & Anderson Prichard Company Ft. from N. Line330 Ft. from S. Line330 Ft. from E. Line Ft. from W. Line

SE NE

1945 Elev. 1639'

REPORT

12/12 Location

12/20 Derrick.

12/29 "

1946

1/10 R.U.R.

1/17 16" - 77' 10" - 788'

Drlg. 1600'

1/24 Drlg. 3685'

1/31 " "

2/7 Viola 4366-4400' T.D.

5" - 4389' RUST.

2/14 T.D. 4402' P.B. to 4381'

21 shots 4362-70' 3000 acid.

2/21 Squeeze 54 shots 4341-55
1000 acid. Swab & flow 3 oil per hour.
4 M gas.2/28 2000 acid. No help.
Squeeze.3/7 48 shots 4324-40 3000 acid.
Squeeze.3/14 71 shots 4327-37' S.S.O.
Simp 4440' Sand 4448-62'
Drlg. 4488'3/21 Arb. 4553-55' T.D.
Run liner.3/28 184' of 4" liner at 4552' T.D. 4559'
2000' oil 12 hours.
Recement liner.

4/4 " " " "

4/10 Pump 23 oil 15 water.

4/16 " " " OVER

1946

4/23	Pump 23 oil &	15 wtr
5/1	"	"
5/7	"	"
5/14	"	"
5/21	"	"
5/29	"	"
6/5	"	"
6/12	Arb 4550 184' of 4" liner @ 4552' 5" @ 4389 Pump 27 oil plus 89% W Pot. 26.0 Gr 4559' TD	

COMPLETED

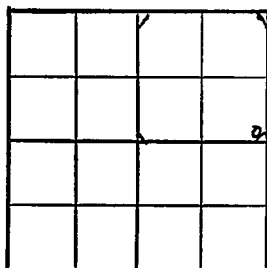
KANSAS

Kansas Pool Name SkinnerMap No. K-93 Sec. 8 Twp. 31 R. 14WWell No. 1 D.W. SkinnerHuber & Anderson Prichard Company~~FIRST REPORT~~

Contractor

SE NE

SECTION PLAT

 Ft. from N. Line330 Ft. from S. Line330 Ft. from E. Line Ft. from W. Line

Barber County

Location XRig up Drilling and Remarks:

RECORD

Cased in., ft.Sand Gas Oil Total Depth

PRODUCTION

1st 24 hrs. Nat. 1st 24 hrs. after shot Gas Cu. Ft.Dry Hole Abandoned

Date

DEC 1 2 1945

19

S. J. LEWIS

Scout

Misc. Shell Fossils *OK*
Cores *Beds*
Tracing *287*
France Map *✓*
Scarborough Map *✓*
Pierce Map *✓*
Geological Dept. _____
Pierce Plat Book _____

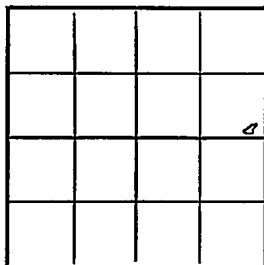
KANSAS

Kansas

Pool Name SkinnerMap No. 93 Sec. 8 Twp. 31 R. 14WWell No. 1 D. W. SkinnerHuber & Anderson Prichard Company**COMPLETED**

Contractor

SE NE

E 1, 1639**SECTION PLAT** Ft. from N. Line330 Ft. from S. Line330 Ft. from E. Line Ft. from W. LineBarber CountyLocation Rig up

Drilling and Remarks:

Ar 44558184' of 4" liner @45525' @ 4389Pump 27021 + 89%W.P. X26 @ 4389**RECORD**Cased in., ft.Sand Gas Oil Total Depth 4559**PRODUCTION**1st 24 hrs. Nat. 1st 24 hrs. after shot Gas Cu. Ft.Dry Hole Abandoned

Date

JUN 12 1946 19S. J. LEWIS

Scout

Misc Small Maps *OK*
Cards *Boat*
Tracing *Fowler*
France Map *✓*
Scarborough Map *✓*
Moody Map *✓*
Geological Dept. _____
Moody Plat Book _____