


DX 78-1

Stevens KANSAS

Section 8 Township 31 Range 38 W

Well No. # 1 Wilson

Company Hugoton Prod.

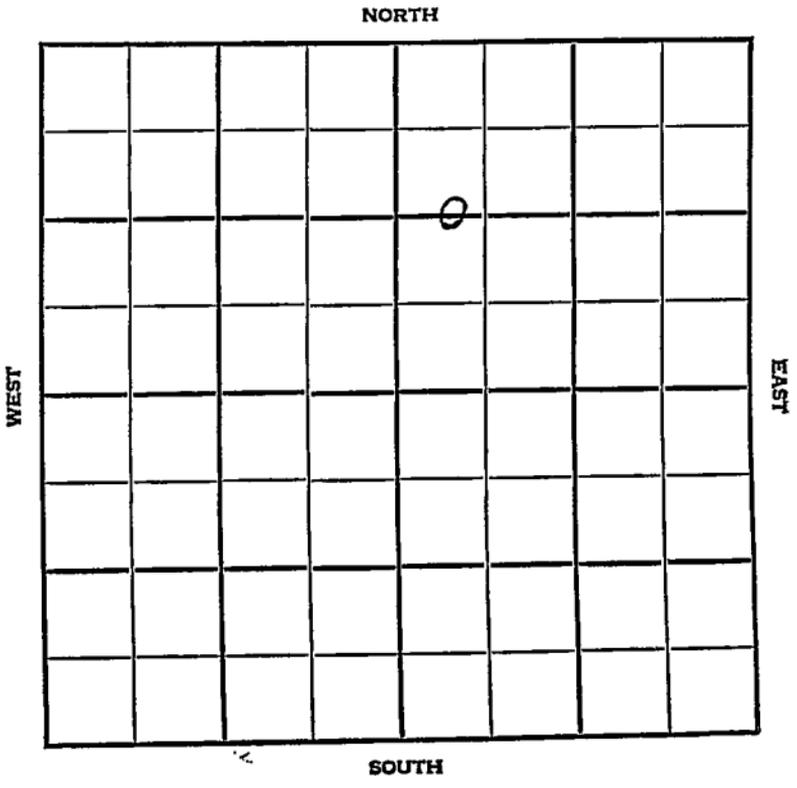

Stevens KANSAS

SEC.	TWP.	R.
8	31	38W

WELL NO. **1 Wilson** FARM

COMPANY **Hugoton Produciton**

CONTRACTOR


**Hugoton Pool**

**1320** Ft. from N. Line

Ft. from S. Line

**2240** Ft. from E. Line

Ft. from W. Line

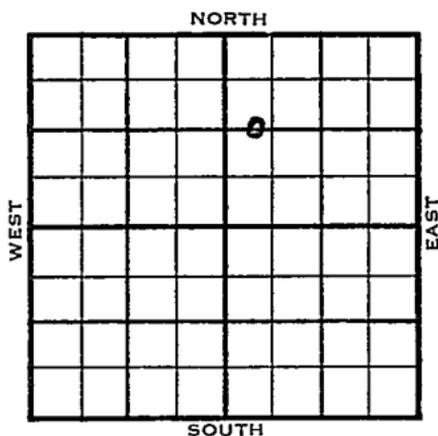

**C W/2 NE**

1954	ELEVATION	REPORT
------	-----------	--------

11/10 Spud 10-27-54  
 10" @ 604'  
 TD 2481'  
 7" @ 2481'  
 DD 2600'  
 5,000 mcfg

12/1 Spud 10-27-54 Gas well TD 2733  
 10" @ 604' Hol. 2439 Her. 2481  
 Kri. 2512 Win. 2571 Ft. Riley 2640  
 TD 2733 5" @ 2641 CO to 2733  
 8000 A 10,258,000 CFG 6000 A  
 13,241,000 CFG  
 Comp. 24,188,000 CFGPD

**COMPLETED**




County Stevens State Kansas

Sec. 8 (Blk. 31 (Sur. 38W (Twp. Map No. (Rge. )

Operator Hugoton Production

Well No. 1 Farm Wilson

Elev. \_\_\_\_\_ Location C W  $\frac{1}{2}$  NE

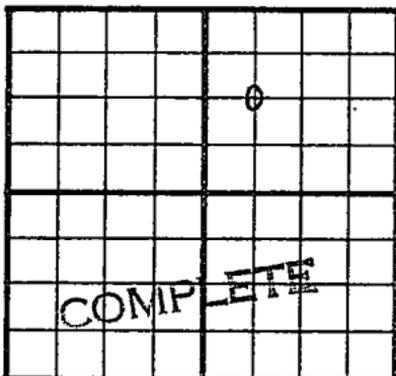

1320 Ft. From N Line NE Quarter

2240 Ft. From E Line Quarter

Ist. Report \_\_\_\_\_

Completion DFC 1 1954

Remarks Hugoton Pool

Spudding Date 10-27-54

Drlg. Data Gas well TD 2733

10" @ 604 Hol. 2439 Her. 2481

Kri. 2512 Win. 2571 Ft. Riley 2640

TD 2733 5" @ 2641 CO to 2733

8000 A 10,258,000 cfg 6000 A

13,241,000 cfg Comp. 24,188,000 cfgpd

FABEN GILSTRAP