


Section 8 Township 31 Range 32W

Well No. 1 G. L. Warren

Company Veeder Supply

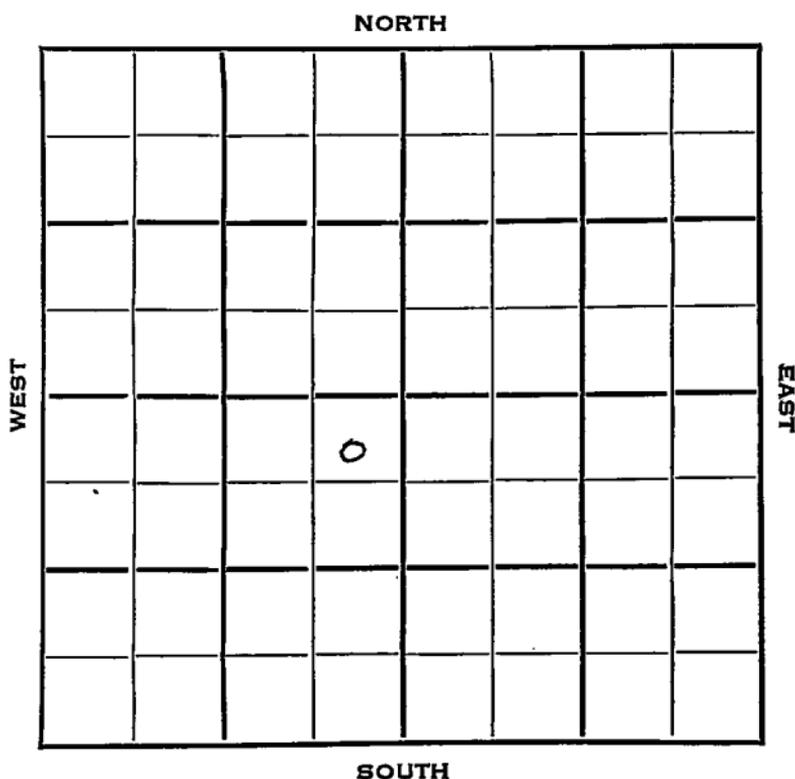

Seward  
31

KANSAS

32W

8

Sec. \_\_\_\_\_ Twp. \_\_\_\_\_ R. \_\_\_\_\_

Well No. #1 G. L. Warren Farm

Veeder Supply Company

Contractor


150 Ft. from N. Line

Ft. from S. Line

150 Ft. from E. Line

Ft. from W. Line

NE SW

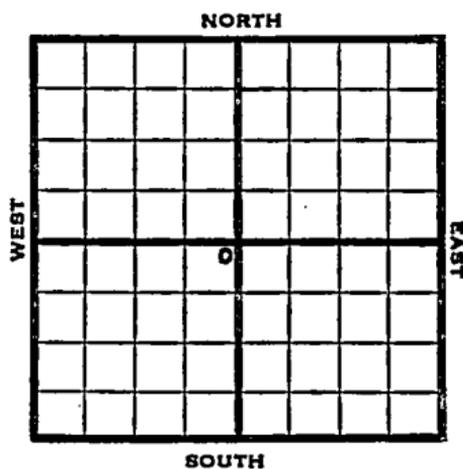

1952 Elev. 2871' REPORT

12/23 Location

12/25 Location

1/1 8" @ 587 25:5

1/8 Ø2595

1/22 RTD 2624  
5" @ 2622

1/29 DD to 2660' - Fish

2/5 NR

2/12 "

2/19 "

2/26 N.R.

3/12 NR

3/18 Spud 12-27-52 Gas well TD 2708'  
8" @ 587 TD 2624 5" @ 2622  
CO to 2624 DD 2660 DD 2708  
Win. 2678' 19,000 A  
Comp. 6,000,000 gas.

**COMPLETED**



County Seward State Kansas

Sec. 8 (Blk. 31) (Sur. 32W) Map No.

Operator Veeder Supply

Well No. 1 Farm G. L. Warren

Elev. 2871 Location NE SW


150 Ft. From N Line SW

150 Ft. From E Line Quarter

Ist. Report

Completion MAR 18 1953

Remarks

Spudding Date 12-27-52

Drlg. Data Gas well TD 2708

8" @ 587 TD 2624 5" @ 2622

CO to 2624 DD 2660 DD 2708

Win. 2678 19000 A

Comp. 6,000,000 gas