


Section 8 Township 31 Range 1 W

Well No. # 1 Zogleman

Company Petroleum Trading & Transport et al

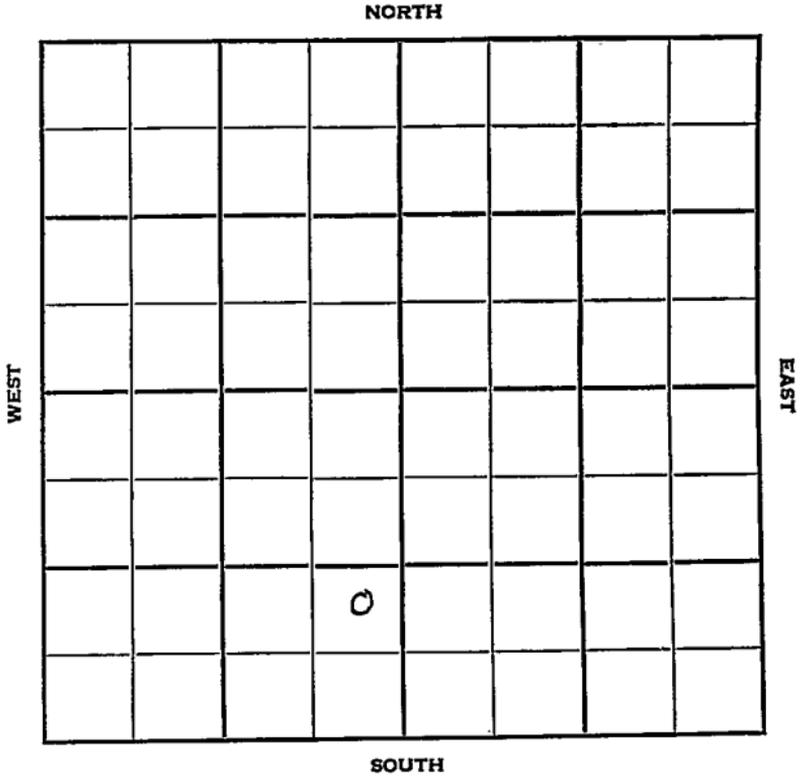

Sec. 8 Twp. 31 R. 1W

Well No. #1 Zogleman Farm

Petroleum Trading & Transport etal Company

Ingling - Contr. Contractor


Wildcat

Ft. from N. Line

990' Ft. from S. Line

330' Ft. from E. Line

Ft. from W. Line

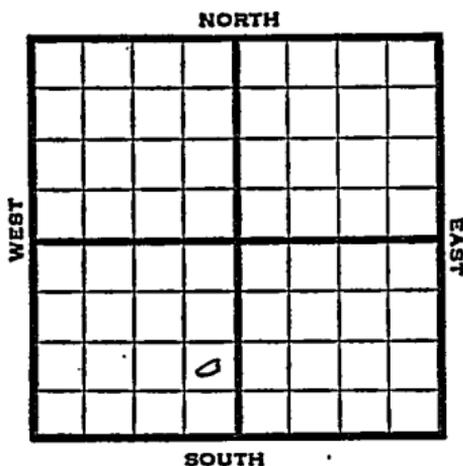

NE SE SW

1951 Elv. 1303' REPORT

3/28 Spud 3-27-51

6/20 Spud 3-27-51 Oil well TD 4060'
 8" @ 327' Top. 1998' Iton 2738'
 Stal. 2742' KC 3224' B KC 3277'
 Mar. 3359' Cherokee 3484' Miss 3668'
 Simp. 4036'
 DST 4038-44 open 45 min. gas in 30 min.
 Flow oil rec 2080' oil, 420' water.
 TD 4060' 5" @ 4058 1/4034
 23/4034-46 FU 2000' fluid 1 hr.
 25/4036-38 FU 3700' fluid overnite
 S/120 BO 84 BW S/87 BO 93 BW 10 hr.
 Comp. 86 BOPD 35% water.

COMPLETED

County Sumner State Kansas

Sec. 8 (Blk. Twp.) 31 (Sur. Rge.) 1W Map No.

Operator Petroleum Trading & Transport etal.

Well No. 1 Farm Zogleman

Elev. 1303 Location NE SE SW

FIRST REPORT

990 Ft. From S Line SW

330 Ft. From E Line Quarter

Ist. Report MAR 28 1951

Completion _____


Remarks Phillips acreage &DH

Ingling - Contr.

Spudding Date 3-27-51

Drlg. Data Wildcat

County Sumner State Kansas
 Sec. 8 (Blk.) 31 (Sur.) 1W Map No.
 Operator Petroleum Trading & Transport etal.
 Well No. 1 Farm Zogleman
 Elev. 1303 Location NE SE SW

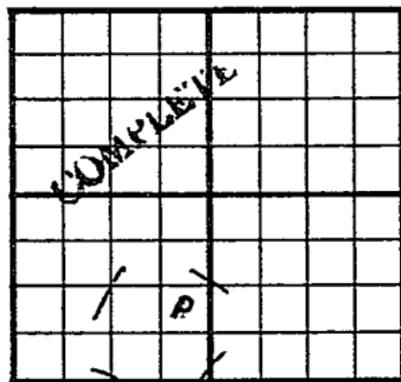

990 Ft. From S Line SW
330 Ft. From E Line Quarter

1st. Report

Completion JUN 20 1951

Remarks Wildcat

Ingling - Contr.

Spudding Date 3-27-51

Drlg. Data Oil well TD 4060

8" @ 327 Top. 1998 Iton 2738

Stal. 2742 KC 3224 B. KC 3277 Mar. 3359

Cherokee 3484 Miss. 3668 Simp. 4036

DST 4038-44 open 45 min. gas in 30 min.

Flow oil Rec. 2080' oil 420' water

TD 4060 5" @ 4058 1/ 4034 23/ 4034-46

FU 2000' fluid 1 hr. 25/ 4036-38

FU 3700' fluid overnite S/ 120 bo 84 bw

S/ 87 bo 93 bw 10 hr.

Comp. 86 bopd 35% water

J. E. TYRA