


DX 78-1

Section 8 Township 31 Range 8WWell No. 2 B & A SmithCompany Republic Natural

NORTH

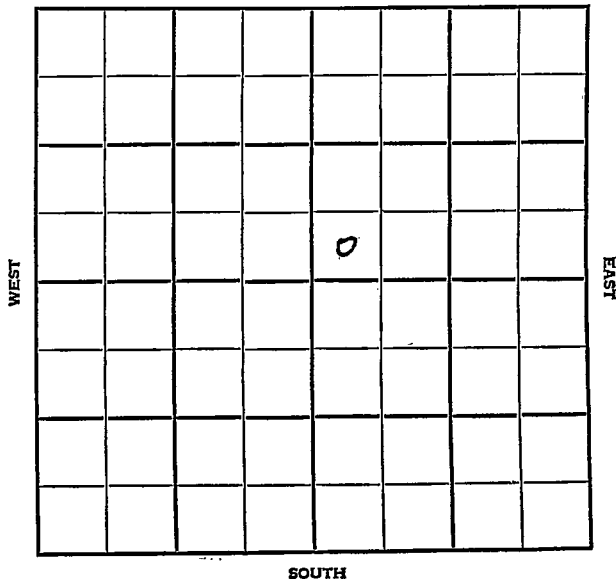

Harper KANSAS

SEC.	TWP.	R.
8	31	8W

WELL NO.

2 B. & A Smith

FARM

COMPANY

Republic Natural

CONTRACTOR

Purcell & Mills

NE Grab Pool

Ft. from N. Line


330

Ft. from S. Line

Ft. from E. Line

330

Ft. from W. Line

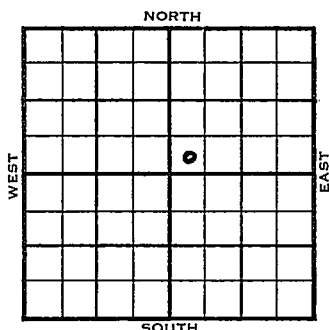

SW SW NE

ELEVATION	REPORT
1954	1651

7/21

Location

8-18

Spdg 7-21-54

Oil well

TD 4525

8" @ 831

Core 4436-92 100% rec.

TD 4525

Miss. 4390

5" @ 4524 CCO 150/ 4400-25 250 M-A

sd-oil-frac Comp. 544 bopd. 8% wtr.

COMPLETED

County Harper State Kansas
 Sec. 8 (Blk.) 31 (Sur.) 8W Map No.
 Operator Republic Natural
 Well No. 2 Farm B & A Smith
 Elev. _____ Location SW SW NE

330 Ft. From S Line NE

330 Ft. From W Line Quarter

1st. Report JUL 21 1954

Completion _____

Remarks _____

Purcell & Mulls - Contr.

Spudding Date _____

NE Grabb Pool

Drlg. Data _____

Location

J. G. McGEHEE

County Harper State Kansas

Sec. 8 (Blk. Twp.) 31 (Sur. Rge.) 8W Map No.

Operator Republic Natural

Well No. 2 Farm B & A Smith

Elev.	1651	Location	SW SW NE
-------	------	----------	----------

COMPLETE

330 Ft. From S Line NE

330 Ft. From W Line Quarter

1st. Report

Completion **AUG 18 1954**

Remarks NE Grabs Pool

Purcell & Mull - Contr.

Spudding Date . 7-21-54

Drilg. Data Oil well TD 4525

8" @ 831 Core 4436-92 100% rec.

TD 4526 Miss. 4390 5" @ 4524 CO

150/ ~~4400~~-25 250 M-A sd-oil-frac

Comp. 544 bopd 8% wtr.

FABEN GILSTRAP