


Section 8 Township 31 Range 8W

Well No. 1 Dickson

Company Frank Purcell & J. A. Mull et al

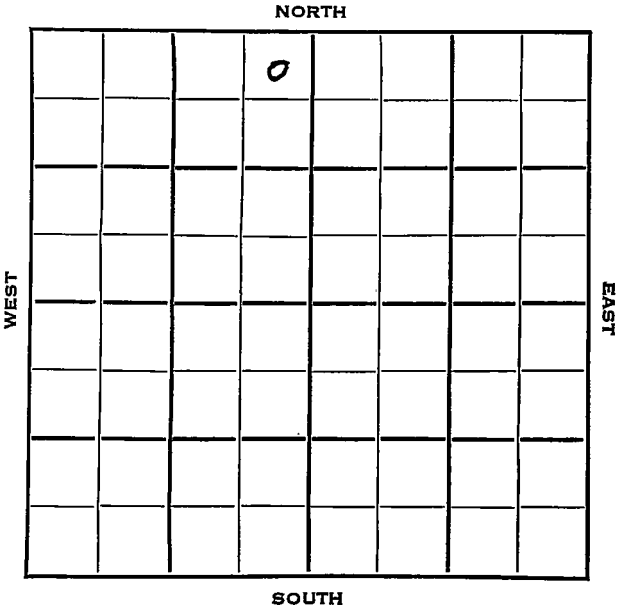

SEC.	TWP.	R.
8	31	8W ✓

WELL NO. _____
 COMPANY 1 Dickson FARM

CONTRACTOR Frank Purcell & J. A. Mull et al


Wildcat

330 Ft. from N. Line

_____ Ft. from S. Line

330 Ft. from E. Line

_____ Ft. from W. Line

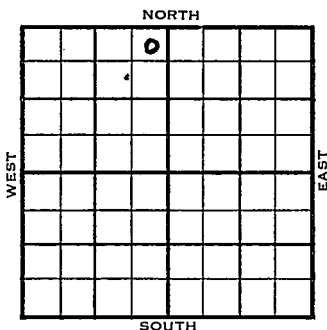

NE NE NW

	ELEVATION	REPORT
1954	1673'	
2/10		Cellar & Pits
2/24		8" @ 178' w/150 sks Drlg 4214'
3/3		Lans 3637', Miss 4386' Ø 4391'-4442' 15' rec. DST 4390'-4409' 1 hr, 60' gcm, 1360# DST 4408'-42' 1½ hr, 90' O&GCM, 90' Hly OCM, 180' O & gcw & M 570# RTD 4442' 5" @ 4417'
3/10		C.O.
3/17		C.O. 4442 frac. lost load DD 4445 frac F avg 12 BOPH 10 hrs. thru tubing.
4/14		Spud 2-11-54 Oil Well TD 4442' 8" @ 178' Lans 3637', Miss 4386' DST 4390'-4409', opn 1 hr., rec. 60' gcm, 1360# DST 4408'-42', opn 1½ hrs., rec. 90' o & gcm, 90' hocm, 180' o & gcm, & m 570# TD 4442'

OVER

(Information Brought Forward)

1954
4/14

5" @ 4417'

CO to 4442'

Frac

DD 4445'

Frac

F/12 boph

Comp. 78 bopd 6% wtr.

COMPLETED

FEB 11 1954

Scout Cards
Land Small Map <i>ld</i>
Land Wall Map <i>3</i>
Tracings
France Map
Pierce Map
Misc.

County Harper State Kansas

Sec. 8 (Blk. 31) (Sur. Rge.) 8W Map No.

Operator Frank Purcell & J. A. Mull etal.

Well No. 1 Farm Dickson

Elev. 1673 Location NE NE NW

		0			

330 Ft. From N Line NW

330 Ft. From E Line Quarter

Ist. Report

APR 14 1954

Completion

Remarks H & H - Contr.

Wildcat

Spudding Date 2-11-54

Drlg. Data Oil well TD 4442

8" @ 178 Lans. 3637 Miss. 4386

DST 4390-4409 open 1 hr. Rec. 60' gcm

1360# DST 4408-42 open 1 1/2 hr. Rec.

90' o & gcm 90' hocm 180' o & gcw & m

570# TD 4442 5" @ 4417 CO to 4442

frac DD 4445 frac F/ 12" boph

Comp. 78 bopd 6% wtr.

J. G. MCGEHEE

APR 20 1954

Scout Cards
Land Small Map
Land Wall Map 33
Tracings
France Map
Pierce Map
Misc.