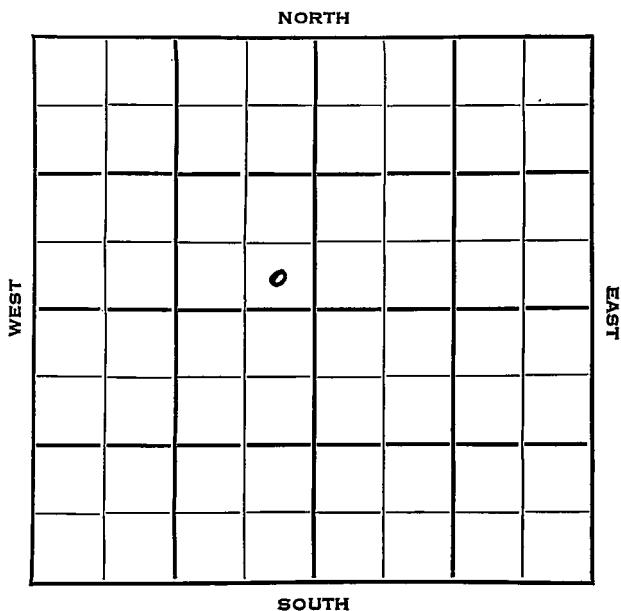


Section 8 Township 31 Range 8WWell No. 2 DicksonCompany Frank Purcell et al

Harper

KANSAS

SEC.	TWP.	R.
8	31	8 W

WELL NO.

2 Dickson

FARM

CONTRACTOR Frank Purcell et al

Pickrell Drlg.


Ft. from N. Line

330 Ft. from S. Line

330 Ft. from E. Line

Ft. from W. Line

SE SE NW

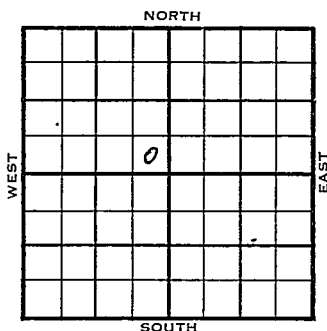

ELEVATION

REPORT

1954 1638'

3/3 Spud 2-28-54
8" @ 160
Drlg. 1430'

3/10 Drlg 3892'

3/17 Miss 4373'
DST 4376'-96' 1½ hr, 180' gcm, 120'
O & GCM, 50' Hly OCM, 10' WCM, 1140#
RTD 4396'
5" @ 4386'

3/24 WOCT.

3/31 DD 4405'
25 goph frac.

4/7 S/4 boph POP

5/5 Spud 2-28-54 Oil well TD 4405'
8" @ 160 Miss 4373
DST 4376-96 open 1½ hr rec 180' GCM
120' O & GCM, 50' HOCM, 10' WCM 1140#
TD 4396 5" @ 4386 DD 4405
25 GOPH frac. S/4 BOPH P/126 BO
24 hr. Comp. 69 BOPD 6% wtr.

COMPLETED

County **Harper** State **Kansas**

Sec. 8 (Blk.) 31 (Sur.) 8W Map No.

Operator **Frank Furcell et al.**

Well No. **2** Farm **Dickson**

Elev.	Location	SE SE NW
-------	----------	----------

0

FIRST REPORT

330 Ft. From S Line NW

330 Ft. From E Line Quarter

1st. Report **MAR 3 1954**

Completion

Remarks

Pickrell Drig. - Contr.

Spudding Date **2-28-54**

Drlg. Data

8" @ 160 drlg. 1430

J. G. McGEHEE

J. G. McGEHEE