


DX 78-1

Harper KANSAS

Section 8 Township 31 Range 8W

Well No. 1 Fleming

Company Sohio Petr.

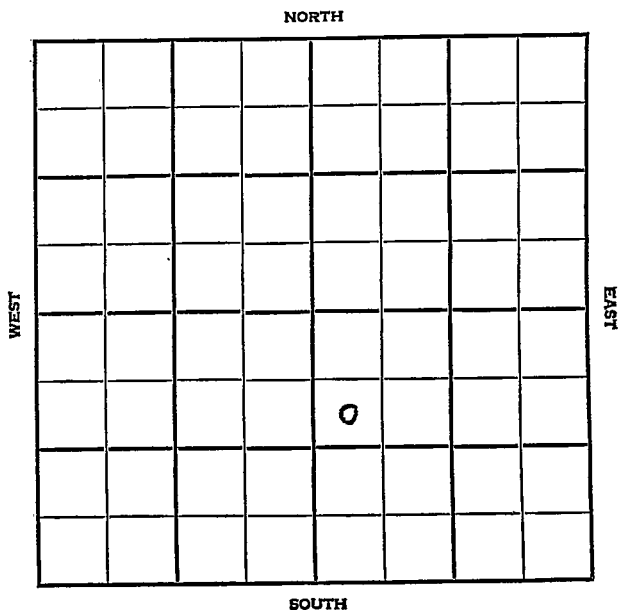

Harper KANSAS

SEC.	TWP.	R.
8	31	8W

WELL NO.

1 Fleming

FARM

COMPANY

Sohio Petr.

CONTRACTOR

Garvey


E. Grabs Pool

990 Ft. from N. Line

Ft. from S. Line

Ft. from E. Line

330 Ft. from W. Line

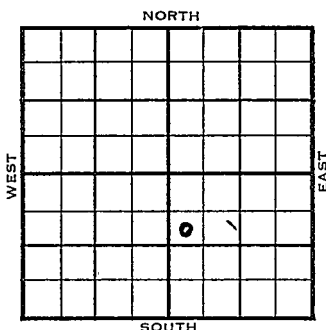

SW NW SE

	ELEVATION	REPORT
1954	1625'	

9/1 RUR

11/3 Spud 9-1-54 - Oil Well

TD 4501'

8" @ 178'

Lans 3608', Miss 4392'

DST 4385-4445', opn 1 hr., gas in 20", 225,000 cfm, 30' gcm, 60' soegm, 240' hocgm, 120' oily mud, 1380#

DST 4445-95', opn 1 hr., rec. 780'

SW, 1520#

TD 4501'

5" @ 4500'

CO to 4467'

40/4420-30

B/15 go 30", 500A

S/1 bo 3/4 bw 3 hrs.

Sd-oil-frac

F/63 bo 51 bw 10 hrs.

P/80 bo 200 bwpd

Comp. 30 bopd 68% wtr.

COMPLETED

County Harper State KansasSec. 8 (Blk.) 31 (Sur.) 8W Map No.Operator Sohio PetroleumWell No. 1 Farm FlemingElev. Location SW NW SE

990 Ft. From N Line SE330 Ft. From W Line Quarter1st. Report SEP 1 1954

Completion

Remarks


Garvey - Contr.

Spudding Date

Drilg. Data E. Grabs PoolRUR

FABEN GILSTRAP

County Harper State Kansas
 Sec. 8 (Blk. 31 (Sur. 8W Map No.
 (Twp.) (Rge.)
 Operator Sohio Petroleum
 Well No. 1 Farm Fleming
 Elev. 1625 Location SW NW SE

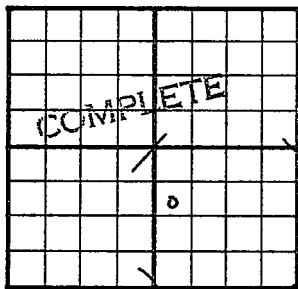

990 Ft. From N Line SE
 330 Ft. From W Line Quarter

1st. Report

Completion NOV 3 1954

Remarks E. Grabs Pool

Garvey - Contr.

Spudding Date 9-1-54

Drlg. Data Oil well TD 4501
8" @ 178 Lans. 3608 Miss. 4392

DST 4385-4445 open 1 hr. gas in 20 min.

225,000 cfg 30' gcm 60' socgm 240'

hocgm 120' oily mud 1380# DST 4445-95

open 1 hr. Rec. 780' sw 1520#

TD 4501 5" @ 4500 CO to 4467

40/ 4420-30 B/ 15 go 30 min. 500 A

S/ 1 bo 3/4 bw 3 hr. sd-oil-frac

F/ 63 bo 51 bw 10 hr. P/ 80 bo 200 bwpd

Comp. 30 bopd 68% wtr.

FABEN GILSTRAP