

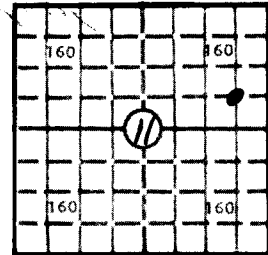
KANSAS

WELL COMPLETION REPORT AND
DRILLER'S LOGAPI No. 15 — 077 — 20,732
County Number

S. 11 T. 31S R. 9W E W

Loc. C SE NE

County Harper

640 Acres
N

Locate well correctly

Elev.: Gr. 1662

DF KB 1675

Operator

Beren Corporation

Address

970 Fourth Financial Center, Wichita, Kansas 67202

Well No.

2

Lease Name

WINGATE

Footage Location

feet from (N) (S) line

feet from (E) (W) line

Principal Contractor

BEREDCO INC

Geologist

Bob Lewellyn

Spud Date

9/30/81

Date Completed

10/7/81

Total Depth

4480

P.B.T.D.

Directional Deviation

Oil and/or Gas Purchaser

CASING RECORD

Report of all strings set — surface, intermediate, production, etc.

Purpose of string	Size hole drilled	Size casing set (in O.D.)	Weight lbs/ft.	Setting depth	Type cement	Sacks	Type and percent additives
Surface	12 1/2"	8-5/8"	20#	292'	60-40 pozmix	225	2% gel, 3% CC

LINER RECORD

PERFORATION RECORD

Top, ft.	Bottom, ft.	Sacks cement	Shots per ft.	Size & type	Depth interval

TUBING RECORD

Size	Setting depth	Packer set at

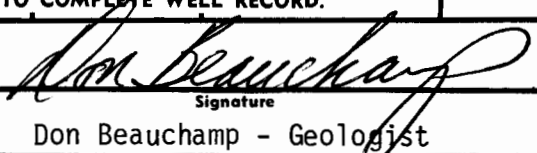
ACID, FRACTURE, SHOT, CEMENT SQUEEZE RECORD

Amount and kind of material used	Depth interval treated

INITIAL PRODUCTION

Date of first production		Producing method (flowing, pumping, gas lift, etc.)			
RATE OF PRODUCTION PER 24 HOURS	Oil bbls.	Gas MCF	Water bbls.	Gas-oil ratio CFPB	
Disposition of gas (vented, used on lease or sold)			Producing interval(s)		

INSTRUCTIONS: As provided in KCC Rule 82-2-125, within 90 days after completion of a well, one completed copy of this Drillers Log shall be transmitted to the State Geological Survey of Kansas, 4150 Monroe Street, Wichita, Kansas 67209. Copies of this form are available from the Conservation Division, State Corporation Commission, 245 No. Water, Wichita, Kansas 67202. Phone AC 316-522-2206. If confidential custody is desired, please note Rule 82-2-125. Drillers Logs will be on open file in the Oil and Gas Division, State Geological Survey of Kansas, Lawrence, Kansas 66044.

Operator Beren Corporation		DESIGNATE TYPE OF COMP.: OIL, GAS, DRY HOLE, SWDW, ETC.:	
Well No. 2	Lease Name WINGATE	Dry Hole	
S <u>11</u> T <u>31</u> S R <u>9</u> W ^E / _W			
WELL LOG Show all important zones of porosity and contents thereof; cored intervals, and all drill-stem tests, including depth interval tested, cushion used, time tool open, flowing and shut-in pressures, and recoveries.		SHOW GEOLOGICAL MARKERS, LOGS RUN, OR OTHER DESCRIPTIVE INFORMATION.	
FORMATION DESCRIPTION, CONTENTS, ETC.	TOP	BOTTOM	NAME
Red Bed	0	1372	
Lime & Shale	1372	4465	
Miss. Chert	4465	4480	
RTD	4480		
USE ADDITIONAL SHEETS, IF NECESSARY, TO COMPLETE WELL RECORD.			
Date Received	 Signature Don Beauchamp - Geologist Title October 22, 1981 Date		