SIDE ONE

15-077-00016-0001

STATE CORPORATION COMMISSION OF KANSAS
OIL & GAS CONSERVATION DIVISION
RECOMPLETION FORM
ACO-2 AMENDMENT TO WELL HISTORY

API No. 15- 07700016

COUNTY HARPER

___ East
_SW__ _NE__ _SW_ Sec_23__ Twp_31S_ Rge_9___ _X_ West

___1650_____ Ft North from Southeast Corner of Section
___3630_____ Ft West from Southeast Corner of Section
(Note: Locate well in section plat below)

Operator: License # 5208
Name MOBIL OIL CORPORATION
Address P.O. BOX 5444
City/State/Zip DENVER, COLORADO 80217

Lease Name MARTIN 'B' WELL # 3

Purchaser TEXACO

Field Name SPIVEY-GRABBS


Operator Contact Person B. R. MAYNARD

Name of New Formation MISSISSIPPI

Phone (303) 298-2069

Elevation: Ground 1624 FT. KB 1635 FT.

SECTION PLAT

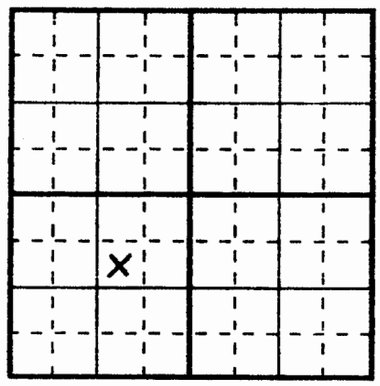

Designate Type of Original Completion
___ New ___ Re-Entry _XX_ Workover

XX_ Oil ___ SWD ___ Temp Abd
___ Gas ___ Inj ___ Delayed Comp.
___ Dry ___ Other (Core, Water Supply, etc.)

Date of Orginal Completion: 2-7-61

DATE OF RECOMPLETION
6-24-88 Commenced
6-29-88 Completed

Designate Type of Recompletion / Workover:

_____ Deepening _____ Delayed Completion
_____ Plug Back _XX_ Re-perforation
___ Conversion to Injection / Disposal

Is recompletion production:

_NA_ Commingled; Docket No. _____
_NA_ Dual Completion; Docket No. _____
_NA_ Other (Disposal or Injection)?

SEP 09 1988
CONSERVATION DIVISION
Wichita, Kansas

K.C.C. OFFICE USE ONLY
F ✓ Letter of Confidentiality Attached
C ___ Wireline Logs Received
C ___ Drillers Timelog Received

Distribution
___ KCC ___ SWD/Rep ___ NGPA
✓ KGS ___ Plug ___ Other (Specify)

INSTRUCTIONS: This form shall be completed in triplicate and filed with the Kansas Corporation Commission, 200 Colorado Derby Building, Wichita, Kansas 67202, within 120 days of the recompletion of any well. Rules 82-3-107 and 82-3-141 apply. Information on side two of this form will be held confidential for a period of 12 months if requested in writing and submitted with the form. See rule 82-3-107 for confidentiality in excess of 12 months. One copy of any additional wireline logs and driller's time logs (not previously submitted) shall be attached with this form. Submit ACO-4 prior to or with this form for approval of commingling or dual completions. Submit CP-111 with all temporarily abandoned wells. NOTE: Conversion of wells to either disposal or Injection MUST receive approval before use; submit form U-1.

All requirements of statutes, rules and regulations promulgated to regulate the oil and gas industry have been fully complied with and the statements herein are complete and correct to the best of my knowledge.

Signature B. R. MAYNARD Title REGULATORY COMPLIANCE ENGINEER Date 9-6-88

Subscribed and sworn to before me this 6th day of September 1988

Notary Public _____ Date Commission Expires 1/3/91

Form ACO-2 (5-88)

SEP 09 1988
KANSAS GEOLOGICAL SURVEY