


KANSAS

WELL COMPLETION REPORT AND
DRILLER'S LOGState Geological Survey
WICHITA BRANCHAPI No. 15 — 077 — 20,582
County Number

S. 29 T. 31 S. R. 9 W

Loc. 600' FSL & 1980' FEL

County Harper

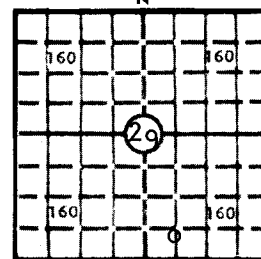640 Acres
N

Elev.: Gr. 1671'

DF 1677' KB 1679'

Operator

Hawkins Oil & Gas, Inc.

Address

Box 1869 Liberal, Kansas 67901

Well No.

#1-29

Lease Name

Parsons

Footage Location

600 feet from (S) line 1980 feet from (E) line

Principal Contractor

DaMac Drilling, Inc.

Geologist

Dave Trumbo

Spud Date

4-7-80

Date Completed

4-15-80

Total Depth

4540'

P.B.T.D.

4498'

Directional Deviation

no

Oil and/or Gas Purchaser

UPG, Inc.

CASING RECORD

Report of all strings set — surface, intermediate, production, etc.

Purpose of string	Size hole drilled	Size casing set (in O.D.)	Weight lbs/ft.	Setting depth	Type cement	Sacks	Type and percent additives
Surface	12 1/4"	8 5/8"	24#	328'	Class H	285	3% cc
Production	7 7/8"	4 1/2"	10.5#	4539'	Class H	50	10% salt, 8% gel, 12 1/2# gilsonite
					50/50 pozmix	150	18% salt, .75% TIC, 12 1/2# gilsonite

LINER RECORD

PERFORATION RECORD

Top, ft.	Bottom, ft.	Sacks cement	Shots per ft.	Size & type	Depth interval
			2	.38 DP	4480-4486
TUBING RECORD					
Size	Setting depth	Packer set at			
2 3/8"	4495'	-			

ACID, FRACTURE, SHOT, CEMENT SQUEEZE RECORD

Amount and kind of material used	Depth interval treated
1500 gal 15% MR-1 acid w/1 1/2 gal I-10, 5 gal Aqua-flow	4480-4486
10,000 gal 20# gelled 1% KCL water + 11,250# of 10/20 sand with	4480-4486
400# J-2, 250# Aquason II, 2 gal FR-26 & 10 gal FS-2	RECEIVED

STATE CORPORATION COMMISSION

INITIAL PRODUCTION

JUL 28 1980

Date of first production	Producing method (flowing, pumping, gas lift, etc.)	Water	Gas	Oil	Gas-oil ratio	CFPB
6-13-80	pumping	2 bbls.	tstm	20 bbls.	-	-
RATE OF PRODUCTION PER 24 HOURS			Wichita Kansas			
Disposition of gas (vented, used on lease or sold)			Producing interval(s)			
lease gas only			4480-4486 Mississippi Chat			

INSTRUCTIONS: As provided in KCC Rule 82-2-125, within 90 days after completion of a well, one completed copy of this Drillers Log shall be transmitted to the State Geological Survey of Kansas, 4150 Monroe Street, Wichita, Kansas 67209. Copies of this form are available from the Conservation Division, State Corporation Commission, 245 No. Water, Wichita, Kansas 67202. Phone AC 316-522-2206. If confidential custody is desired, please note Rule 82-2-125. Drillers Logs will be on open file in the Oil and Gas Division, State Geological Survey of Kansas, Lawrence, Kansas 66044.

Well No.	1-29	Lease Name	PARSONS	
S <u>29</u> T <u>31</u> S <u>9</u> E <u>W</u>				
WELL LOG Show all important zones of porosity and contents thereof; cored intervals, and all drill-stem tests, including depth interval tested, cushion used, time tool open, flowing and shut-in pressures, and recoveries.			SHOW GEOLOGICAL MARKERS, LOGS RUN, OR OTHER DESCRIPTIVE INFORMATION.	
FORMATION DESCRIPTION, CONTENTS, ETC.	TOP	BOTTOM	NAME	DEPTH
Sand, Shale	0	130		
Red Bed	130	570		
Red Bed, Shale	570	1650		
Lime, Shale	1650	4540		
USE ADDITIONAL SHEETS, IF NECESSARY, TO COMPLETE WELL RECORD.				
Date Received	<i>Thad E. Leary</i> Signature Agent/Hawkins Oil & Gas, Inc. Title July 25, 1980 Date			

29-31-9W

PLAT AND CERTIFICATION OF ACREAGE ATTRIBUTABLE TO AN OIL WELL

State Corporation Commission, Conservation Division
 245 North Water Wichita, Kansas 67202

OPERATOR HAWKINS OIL & GAS, INC.

LOCATION OF WELL

LEASE PARSONS

600 feet from the south line
1980 feet from the east line
 Of the SE/4 of Sec. 29 T31S R. 9W

WELL NUMBER 1-29

FIELD _____

COUNTY HARPER


ORDER GRANTING ALLOWABLE ENTERED IN DOCKET NO. _____

NUMBER OF ACRES
ATTRIBUTABLE TO WELL 160

DESCRIPTION OF ACREAGE:

P L A T

(Show location of Well and outline attributable acreage)

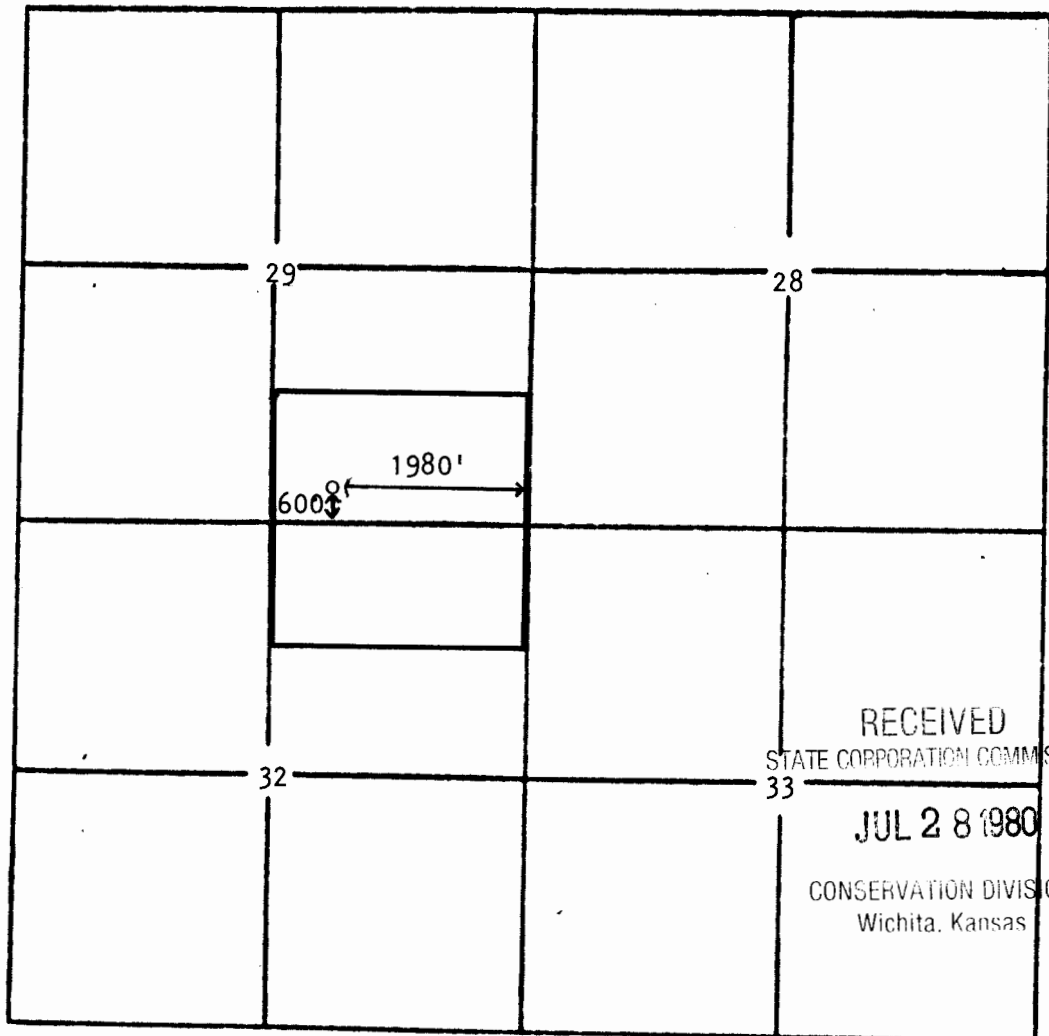

The undersigned hereby certifies that he is Ned E. Lowry