

DX 78-1

Barber

**KANSAS**

Section 9 Township 31 Range 13W

Well No. #1 Vettner

Company Aurora Gasoline

NORTH

							0

WEST

EAST

SOUTH

Barber

**NOT FILE**

KANSAS


SEC. 9 TWP. 31 R. 13W

WELL NO. **1 Nettner** FARM

COMPANY **Aurora Gasoline**

CONTRACTOR

\_\_\_\_\_ Ft. from N. Line  
\_\_\_\_\_ Ft. from S. Line  
\_\_\_\_\_ Ft. from E. Line  
\_\_\_\_\_ Ft. from W. Line

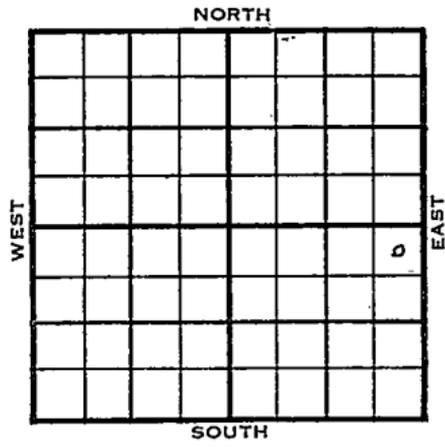

NE NE SE  
Phillips & Sohio - FO  
Sunray-Mid Continent offset #3000 DHM

1955	ELEVATION	REPORT
	1667'	

5/26 Spdg.

5/26 Spud 5-17-55, 8 5/8" @ 217 w/200  
Drlg 3400'

6/2 Heeb 3602', L. Doug 3757', Lans 3789  
Miss 4273  
DST 3754-91, open 1 hr. rec 2200' SW  
BHP 1420/20".  
DST 4270-94 ?

6/9 Heeb 3599', Doug 3757', Lans 3784'  
Miss 4259', Meisner 4363', Viola 4453'  
Simp. 4551', Simp. sd. 4567',  
Arb. 4651' RTD 4710'  
DST 3754-91 open 1 hr rec 2200' SW  
1420/20"  
DST 4270-94, open 1 hr rec 30' SGCM Off  
D & A

**ABANDONED**



County Barber ✓ Elev. 1667  
 Sec. 9 Twp. 31 Rge. 13W  
 Company Aurora Gasoline  
 Farm Name Kettner No. 1

TOPS	DEPTH	LOG	DATUM
Anh.			
Tp.			
H.	<u>3602</u>	<u>3599</u>	<u>1932</u>
Tr.			
Dg.	<u>3757</u>		<u>2090</u>
Bl.			
L.	<u>3789</u>	<u>3784</u>	<u>2117</u>
K.C.			
B.K.C.			
Ce.			
C.			
M.	<u>4273</u>	<u>4259</u>	<u>2592</u>
M.			
K.			
Mz.		<u>4363</u>	<u>2696</u>
Ma.			
V.		<u>4453</u>	<u>2786</u>
S.	<u>4540</u>	<u>4551</u>	<u>2884</u>
S.	<u>4567</u>		<u>2900</u>
A	<u>4657</u>	<u>4651</u>	<u>2984</u>
R.			
Pe.			
G.			
T.D.	<u>4710</u>		

Loc. in Sec. NE NE SE  
 Geol. \_\_\_\_\_  
 Contr. \_\_\_\_\_  
 Pool \_\_\_\_\_


ABANDONED

Date Comm. 5-17-55 JUN 8 1955  
8 5/8" @ 217/200 DST 3754-91 open 1 hr  
Rec. 2200' sw 1420/20" DST 4270-94  
open 1 hr. Rec. 30' sgcm 0#  
D & A

Co.  
Lse.  
No.  
Sec.  
T.  
R.