


Barber KANSAS

Section 9 Township 31 Range 14W

Well No. 3 Mills

Company Huber & Cities Service
Skinner

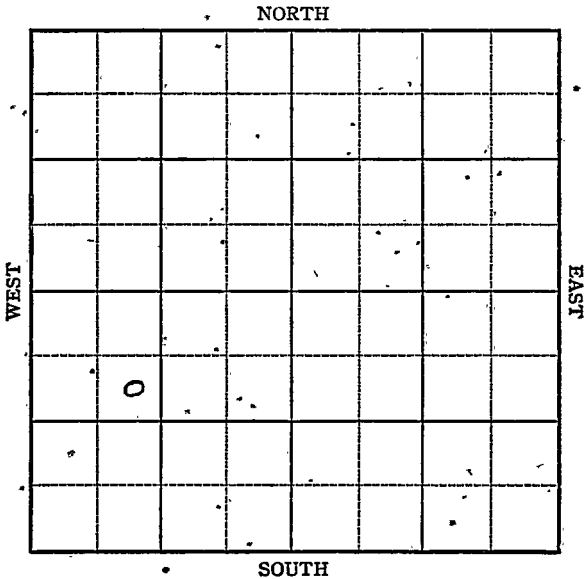

KANSAS

Barber

Sec. 9 Twp. 31 R. 14-W

Well No. #3 Mills Farm


Huber & Cities Service Company
Skinner Pool

990 Ft. from N. Line

 Ft. from S. Line

 Ft. from E. Line

990 Ft. from W. Line

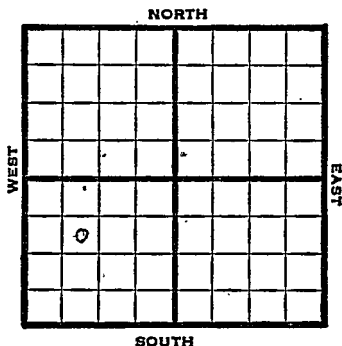

SE NW SW

1947 Elev. 1628' REPORT

3/19 Location

3/25 "

4/2 "

4/9 "

4/15 "

4/23 RUR

4/29 Drlg 110'

5/7 16" @ 117'
10" @ 775'
Drlg. 2175'

5/13 Dr/g 3920'

5/20 Lens 3760
Magwoketa 4320-50
TD 4350'
5" @ 4335'
RUST

5/27 " "

6/3 " "

OVER

6/10 5" @ 4335'
RUST

6/18 Maquoketa 4320'
5" @ 4335'
500 Acid
Boms & Pot 860'
40.0 Gr.
TD 4360'

COMPLETED

Map No. 93 Sec. 9 Twp. 31 R. 14W

Well No. 3 Mills

Huber & Cities Service Company

FIRST REPORT

Contractor

SE NW SW

SECTION PLAT

990 Ft. from N. Line

 Ft. from S. Line

 Ft. from E. Line

990 Ft. from W. Line

Barber County

Location X

Rig up

Drilling and Remarks:

RECORD

Cased in., ft.

Sand

Gas

Oil

Total Depth

PRODUCTION

1st 24 hrs. Nat.

1st 24 hrs. after shot

Gas Cu. Ft.

Dry Hole

Abandoned

Date

MAR 1 9 1947 19

S. J. LEWIS Scout

Misc. Small Maps

Cards *OK*

Tracing *LM*

France Map *OK*

Scarborough Map *OK*

Pierce Map *OK*

Ceological Dept.


Pierce Plate Book

Map No. 93 Sec. 9 Twp. 31 R. 14WWell No. 3 MillsHuber & Cities Service Company

COMPLETE

Contractor

SE NW SW

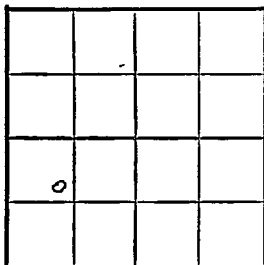E. 1. 1628
SECTION PLAT990 Ft. from N. Line Ft. from S. Line Ft. from E. Line990 Ft. from W. LineBarber CountyLocation Rig up

Drilling and Remarks:

Magnum 4320
5" 4335
500 Acial
Born & P 860

40 2/3

RECORD

Cased in., ft.Sand Gas Oil Total Depth 4360

PRODUCTION

1st 24 hrs. Nat. 1st 24 hrs. after shot Gas Cu. Ft.Dry Hole Abandoned

Date


JUN 1 8 1947

19

S. I. LEWIS

Scout

7734

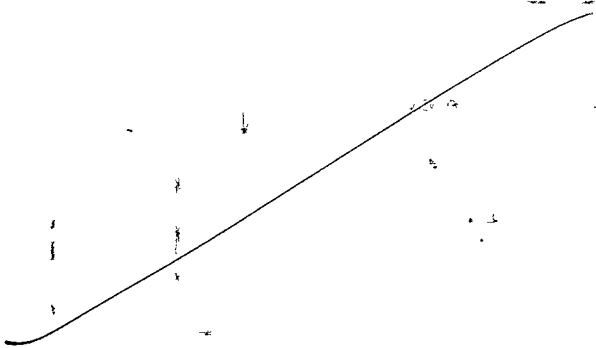

Misc. Small Maps	
Cards	<i>[initials]</i>
Tracing	<i>[initials]</i>
France Map	<i>[initials]</i>
Scarborough Map	<i>[initials]</i>
Fierce Map	<i>[initials]</i>
Ecological Dept.	
Fierce Flat Book	